

Landowner
 C. Salt
 4-3-80

MISSISSIPPI
 BOARD OF WATER COMMISSIONERS
 416 North State Street
 Jackson, Mississippi 39201

WATER WELL DRILLERS LOG

April 3 1980 Mid South Drilling Landowdes
 date well completed firm name county well located


LANDOWNER: <u>Otis Perkins</u>	description of formations encountered	from	to
<u>Columbus, MS</u> (mailing address)			
WELL LOCATION: sec <u>33</u> T <u>17</u> R <u>18</u> <u>2</u> miles <u>N</u> of <u>Col.</u> (distance) (direction) (nearest town)	<u>clay</u>	<u>4</u>	<u>12</u>
WELL PURPOSE: <u>Home</u> (home, irrigation, municipal, industrial)	<u>sand & gravel</u>	<u>12</u>	<u>28</u>
WELL COMPLETION DATA: (1) diameter (inches) <u>4</u>	<u>clay</u>	<u>28</u>	<u>45</u>
(2) total depth (feet) <u>90</u>	<u>clay & sand</u>	<u>45</u>	<u>50</u>
(3) static water level (feet) <u>2</u> below top of ground.	<u>clay</u>	<u>50</u>	<u>55</u>
(4) casing <u>PVC</u> <u>60</u> (material) (depth)	<u>sand</u>	<u>55</u>	<u>60</u>
<u>4</u> if telescope see back. (size)	<u>clay & sand</u>	<u>60</u>	<u>75</u>
(5) screen <u>None</u> (length) (depth to top)	<u>sand</u>	<u>75</u>	<u>90</u>
(size) (material)			
(6) pump <u>3/4</u> <u>10</u> (HP) (yield gpm)			
(type power)			
(7) electric log <u>no</u> (yes or no)			
<u>no</u> (organization running log)			
(8) how well bottom plugged <u>open</u>			
DRILLERS REMARKS:			

DEPT. OF NATURAL RESOURCES
 BUREAU OF LAND & WATER RESOURCES

JUL 14 1980
 RECEIVED

If well telescopes please sketch and show depths.

GROUND LEVEL

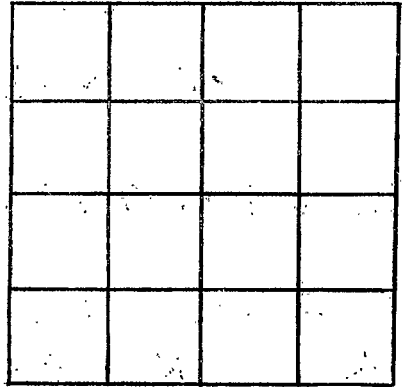

SECTION _____

Please indicate well location X.

ADDITIONAL INFORMATION

If more than one screen,
show locations of each on sketch.