

Lowndes  
 C 2027  
 9-15-80

MISSISSIPPI  
 BOARD OF WATER COMMISSIONERS  
 416 North State Street  
 Jackson, Mississippi 39201

WATER WELL DRILLERS LOG

9-15  
 date well completed

1980 Martin S. Kibben  
 firm name

Lowndes  
 county well located

LANDOWNER: James E. Morley  
 Rt 5 - Box 263  
 Columbus ms. 39701  
 (mailing address)

description of formations encountered	from	to
yellow clay	0	19
blue clay	19	98
sand	98	103
clay	103	117
clay to sand / streaks	117	260

WELL LOCATION:  
 sec. 20 T. 17 N. R. 18 E.  
 S W  
 1 miles NORTH of COLUMBUS  
 (distance) (direction) (nearest town)

WELL PURPOSE: Home  
 (home, irrigation, municipal, industrial)

- WELL COMPLETION DATA:
- (1) diameter (inches) 4"
  - (2) total depth (feet) 260'
  - (3) static water level (feet) 50 below top of ground
  - (4) casing PVC; 120' (material) (depth)  
 4" (size) if telescope see back.
  - (5) screen (length) (depth to top)  
 (size) (material)
  - (6) pump 1/2 (HP) 10 (yield gpm)  
 E. (type power)
  - (7) electric log (yes or no)  
 (organization running log)
  - (8) how well bottom plugged

DEPT. OF NATURAL RESOURCES  
 BUREAU OF LAND & WATER RESOURCES


NOV - 5 1980

RECEIVED

DRILLERS REMARKS:  
 open hole

If well telescopes please sketch and show depths.

GROUND LEVEL

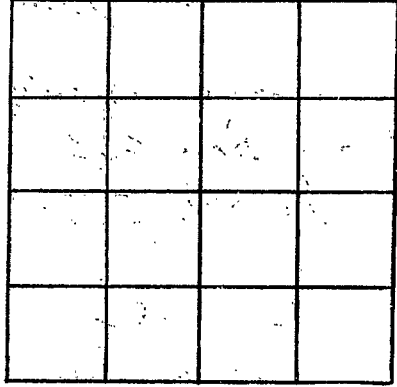

SECTION \_\_\_\_\_

Please indicate well location X.

ADDITIONAL INFORMATION

If more than one screen, show locations of each on sketch.