

Lowndes

C 2028

9-17-80

MISSISSIPPI
 BOARD OF WATER COMMISSIONERS
 416 North State Street
 Jackson, Mississippi 39201

WATER WELL DRILLERS LOG

9-17 1980
date well completed

Mark S. Reddick Lowndes
firm name county well located

LANDOWNER: Regis Livingston

Rt 5 - Box 264

Columbus, MS. 39701
(mailing address)

WELL LOCATION:

sec. 20 17 T N R 18 W
S W
1 miles north of Columbus
(distance) (direction) (nearest town)

WELL PURPOSE: water
(home, irrigation, municipal, industrial)

WELL COMPLETION DATA:

- (1) diameter (inches) 4"
- (2) total depth (feet) 260
- (3) static water level (feet) 55 below above top of ground.
- (4) casing PVC, 140
(material), (depth)
(size) if telescope see back.
- (5) screen _____
(length) (depth to top)
(size) (material)
- (6) pump 1/2 10
(HP) (yield gpm)
6.1
(type power)
- (7) electric log _____
(yes or no)

(organization running log)
- (8) how well bottom plugged _____

description of formations encountered

from to

yellow clay 0 20

Blue clay 20 100

sand 100 104

clay 104 117

clay & sand
strata 117 260

DEPT. OF NATURAL RESOURCES
BUREAU OF LAND & WATER RESOURCES

NOV - 5 1980


RECEIVED

DRILLERS REMARKS:

open hole

If well telescopes please
sketch and show depths.

GROUND LEVEL

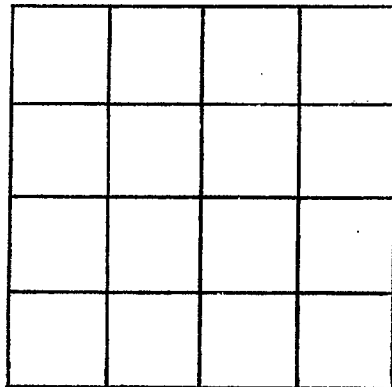

SECTION _____

Please indicate well location X.

ADDITIONAL INFORMATION

If more than one screen,
show locations of each on sketch.