

MISSISSIPPI DEPARTMENT OF NATURAL RESOURCES

Bureau of Land and Water Resources

Southport Mall

P.O. Box 10631

Jackson, Mississippi 39209

WATER WELL DRILLERS LOG

LOWNDES
C 2029
11-4-80

11-4-80 date well completed 1980 Clardy Well Drilling Lowndes firm name county well located

LANDOWNER:
 Lakeview Mission
 Columbus, Miss.
 (mailing address)

WELL LOCATION:
 sec. 20 T 17 N R 18 E
 2 1/2 miles N of Columbus
 (distance) (direction) (nearest town)

WELL PURPOSE: Church
 (home, irrigation, municipal, industrial)

- WELL COMPLETION DATA:
- (1) diameter (inches) 4"
 - (2) total depth (feet) 275'
 - (3) static water level (feet) 18' below top of ground.
 - (4) casing PVC, 69' (material) (depth)
 (size) if telescope see back.
 - (5) screen (length) (depth to top)
 (size) (material)
 - (6) pump 1/2 (HP) 800 (yield-gpm) gpb
 Elec. (type power)
 - (7) electric log NO (yes or no)
 (organization running log)
 - (8) how well bottom plugged

description of formations encountered	from	to
blue clay	25	104
sand	104	110
rock	110	
sand	110	113
blue clay (sandy)	113	140
blue clay	140	160
clay	160	270
sand	270	272
clay	270	275

DEPT. OF NATURAL RESOURCES
 BUREAU OF LAND & WATER RESOURCES


DEC - 8 1980

RECEIVED

DRILLERS REMARKS:

If well telescopes please sketch and show depths.

GROUND LEVEL

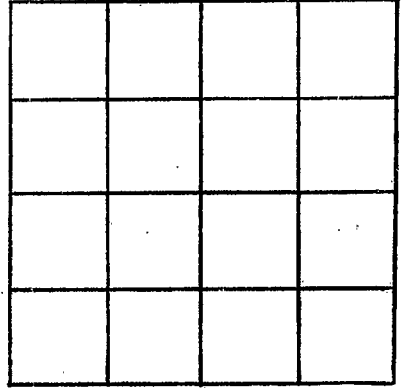

SECTION _____

Please indicate well location X.

ADDITIONAL INFORMATION

If more than one screen,
show locations of each on sketch.