

MISSISSIPPI DEPARTMENT OF NATURAL RESOURCES

Bureau of Land and Water Resources

Southport Mall

P.O. Box 10631

Jackson, Mississippi 39209

WATER WELL DRILLERS LOG

LOWNDES
C 2030
12-9-80

12-9
 date well completed

1980 Clardy Well Drilling Lowndes
 firm name county well located

LANDOWNER: Billy Thompson
524 Holly Hills Rd.
Columbus, Miss.
 (mailing address)

WELL LOCATION:
 sec. 30 T. 17 N. R. 18 E.
1 1/4 miles NW of Colb.
 (distance) (direction) (nearest town)

WELL PURPOSE: None
 (home, irrigation, municipal, industrial)

- WELL COMPLETION DATA:
- (1) diameter (inches) 4"
 - (2) total depth (feet) 178'
 - (3) static water level (feet) 18' below above top of ground.
 - (4) casing PVC, 58'
 (material) (depth)
4" 103'-2" pipe
 (size) if telescope see back.
 - (5) screen 20', 110' to 130'
 (length) (depth to top)
2", P.V.C.
 (size) (material)
 - (6) pump 1/2 900 gph.
 (HP) (yield gph)
Elc.
 (type power)
 - (7) electric log no
 (yes or no)
 (organization running log)
 - (8) how well bottom plugged _____

description of formations encountered	from	to
Surface sand	10	30
Blue clay	30	60
sandy blue clay	60	121
sand	121	130
sandy clay	130	158
sand	158	159
sandy clay	159	161
sand	161	162
sandy clay	162	166
sand	166	167
Clay	167	178

DEPT. OF NATURAL RESOURCES
 BUREAU OF LAND & WATER RESOURCES

JAN 9 1981

RECEIVED

DRILLERS REMARKS: _____


If well telescopes please sketch and show depths.

GROUND LEVEL

58' 4"

Screen
110'-130'

103' - 2" pipe

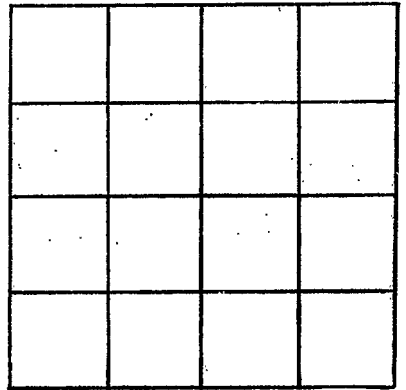

SECTION _____

Please indicate well location X.

ADDITIONAL INFORMATION

If more than one screen,
show locations of each on sketch.