

MISSISSIPPI DEPARTMENT OF NATURAL RESOURCES

Bureau of Land and Water Resources

Southport Mall

P.O. Box 10631

Jackson, Mississippi 39209

WATER WELL DRILLERS LOG

Louises  
C 2034

7-16-84 date well completed Clardy Well Drilling firm name Louises county well located

LANDOWNER: Ed. Dangenhold  
Yorkville, Rd.  
Columbus, Miss.  
(mailing address)

WELL LOCATION:  
sec. 39 T. 17 N. R. 12 E.  
1 1/2 miles No. of Cols.  
(distance) (direction) (nearest town)

WELL PURPOSE: Home  
(home, irrigation, municipal, industrial)

- WELL COMPLETION DATA:
- (1) diameter (inches) 4"
  - (2) total depth (feet) 322'
  - (3) static water level (feet) 69' below above top of ground.
  - (4) casing PVC 1 1/4"  
(material) (depth)  
           if telescope see back.  
(size)
  - (5) screen                        
(length) (depth to top)  
(size) (material)
  - (6) pump 3/4 1000 gph.  
(HP) (yield gpm)  
elec.  
(type power)
  - (7) electric log No.  
(yes or no)  
            
(organization running log)
  - (8) how well bottom plugged

description of formations encountered	from	to
red sandy clay	0	27
blue sandy clay	27	131
good clay	131	187
sandy clay	187	199
sand	199	199
hard clay	199	220
sandy clay	220	222
small rock	222	222
hard clay	222	246
rock	246	247
sandy clay	247	258
hard clay	258	266
sand	266	273
sandy clay	273	292
sand	292	297
hard clay	297	305
sandy clay	305	322


DRILLERS REMARKS:           

DEPT. OF NATURAL RESOURCES  
BUREAU OF LAND & WATER RESOURCES

SEP - 1984  
RECEIVED

If well telescopes please sketch and show depths.

GROUND LEVEL

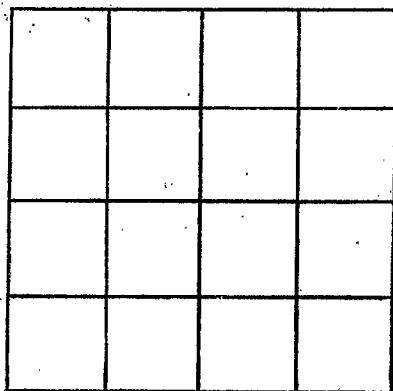

SECTION \_\_\_\_\_

Please indicate well location X.

ADDITIONAL INFORMATION

If more than one screen,  
show locations of each on sketch.