

MISSISSIPPI DEPARTMENT OF NATURAL RESOURCES
Bureau of Land and Water Resources
 Southport Mall
 P.O. Box 10631
 Jackson, Mississippi 39209
WATER WELL DRILLERS LOG

Lowndes
C 2036

5-6 1919 Clardy Well Drilling Lowndes
 date well completed firm name county well located

LANDOWNER: Johnny Bishop
3202 Hwy 82 E
Columbus, Miss.
 (mailing address)

WELL LOCATION:
 sec. 3 T 17 N R. 18 E
6 miles N of Colo.
 (distance) (direction) (nearest town)

WELL PURPOSE: Home
 (home, irrigation, municipal, industrial)

WELL COMPLETION DATA:

- (1) diameter (inches) 4"
- (2) total depth (feet) 119'
- (3) static water level (feet) 28' below above-top of ground.
- (4) casing PVC, 95'
 (material) (depth)
 _____ if telescope see back.
 (size)
- (5) screen _____
 (length) (depth to top)

 (size) (material)
- (6) pump 1/2 900
 (HP) (yield gpm) gph
elec.
 (type power)
- (7) electric log no
 (yes or no)

 (organization running log)
- (8) how well bottom plugged _____

| description of formations encountered | from | to |
|---------------------------------------|----------------|----------------|
| <u>sand & gravel</u> | <u>14</u> | <u>45 1/2</u> |
| <u>Clay</u> | <u>45 1/2</u> | <u>62 1/2</u> |
| <u>Clay</u> | <u>62 1/2</u> | <u>104</u> |
| <u>sand</u> | <u>104</u> | <u>111</u> |
| <u>Clay</u> | <u>111</u> | <u>115</u> |
| <u>sand</u> | <u>115</u> | <u>118 1/2</u> |
| <u>Clay</u> | <u>118 1/2</u> | <u>119</u> |

DRILLERS REMARKS: _____


DEPT. OF NATURAL RESOURCES
 BUREAU OF LAND & WATER RESOURCES

JUL - 1 1982

RECEIVED

If well telescopes please sketch and show depths.

GROUND LEVEL

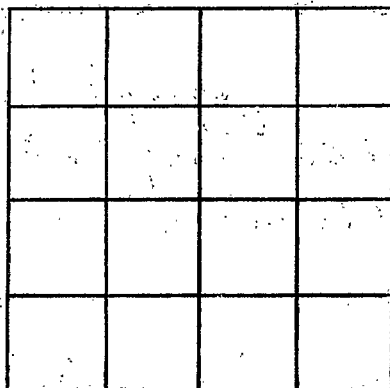

SECTION _____

Please indicate well location X.

ADDITIONAL INFORMATION

If more than one screen, show locations of each on sketch.