

MISSISSIPPI DEPARTMENT OF NATURAL RESOURCES

Bureau of Land and Water Resources

Southport Mall

P.O. Box 10631

Jackson, Mississippi 39209

WATER WELL DRILLERS LOG

Lowndes  
OC  
2037

4-5 19Clardy Well Drilling Lowndes  
 date well completed firm name county well located

LANDOWNER: Victor Moreno  
Nelson Rd.  
Columbus, Ms.  
 (mailing address)

WELL LOCATION:  
 sec. 12 T. 17 N. R. 18 E.  
6 miles N of Columbus  
 (distance) (direction) (nearest town)

WELL PURPOSE: home  
 (home, irrigation, municipal, industrial)

WELL COMPLETION DATA:

- (1) diameter (inches) 4"
- (2) total depth (feet) 162'
- (3) static water level (feet) 12 below above top of ground.
- (4) casing Pvc 80'  
 (material) (depth)  
 \_\_\_\_\_ if telescope see back.  
 (size)
- (5) screen \_\_\_\_\_  
 (length) (depth to top)  
 \_\_\_\_\_  
 (size) (material)
- (6) pump 1/2 900 gph  
 (HP) (yield gpm)  
 \_\_\_\_\_  
 (type power)
- (7) electric log \_\_\_\_\_  
 (yes or no)  
 \_\_\_\_\_  
 (organization running log)
- (8) how well bottom plugged \_\_\_\_\_

description of fomations encountered	from	to
Sandy	0	6
gravel	6	14
red clay	14	20
blue clay	20	62'
Sandy blue clay	62	68 1/2
Clay	68 1/2	86
red c.	86	88
Clay	88	110
Sand	110	110 1/2
Clay	110 1/2	120
Sand (4")	120	
Gummy brown clay	120	142
Sandy streaks	142	162

DEPT. OF NATURAL RESOURCES  
 BUREAU OF LAND & WATER RESOURCES


MAY 18 1982

RECEIVED

DRILLERS REMARKS: \_\_\_\_\_

If well telescopes please sketch and show depths.

GROUND LEVEL

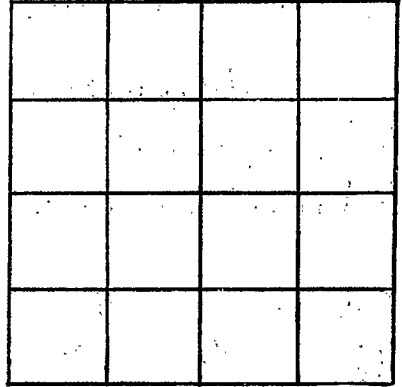

SECTION \_\_\_\_\_

Please indicate well location X.

ADDITIONAL INFORMATION

If more than one screen,  
show locations of each on sketch.