

MISSISSIPPI DEPARTMENT OF NATURAL RESOURCES

Bureau of Land and Water Resources

Southport Mall

P.O. Box 10631

Jackson, Mississippi 39209

WATER WELL DRILLERS LOG

LOWNDES
C 2040
11-20-81

11-20 1981 Clardy W. Drilling Lowndes
date well completed firm name county well located

LANDOWNER: Wendy Wright
Stow Rt Box 96
Columbus, Miss.
(mailing address)

WELL LOCATION:
sec. 13 T. 17 N. R. 12 E
5 1/2 miles no of Col.
(distance) (direction) (nearest town)

WELL PURPOSE: Home
(home, irrigation, municipal, industrial)

- WELL COMPLETION DATA:
- (1) diameter (inches) 4"
 - (2) total depth (feet) 162'
 - (3) static water level (feet) 17 below above top of ground.
 - (4) casing PVC, 64'
(material) (depth)
 if telescope see back.
(size)
 - (5) screen ,
(length) (depth to top)
 (size) (material)
 - (6) pump 1/2 900 gph
(HP) (yield gph)
elec.
(type power)
 - (7) electric log No.
(yes or no)
 (organization running log)
 - (8) how well bottom plugged

description of formations encountered	from	to
Sand & Gravel	14	35
Rock	35	35 1/2
Clay	35 1/2	79
Rock	79	79 1/2
Clay	79 1/2	81
Sand	81	82 1/2
Rock	83	
Clay	83	87
Small rock	87	
Clay	87	107
Sand	107	109
Clay	109	112
Sand	112	113 1/2
Clay	113 1/2	126
Rock	126	
Clay	126	142
Sand	142	144
Clay	144	151
Sand	151	151 1/2
Clay	151 1/2	153
Sand & sand	153	156 1/2
Clay	156 1/2	160
Sand	160	161 1/2
Clay	161 1/2	162

DEPT. OF NATURAL RESOURCES
BUREAU OF LAND & WATER RESOURCES


DEC 18 1981

RECEIVED

DRILLERS REMARKS:

If well telescopes please sketch and show depths.

GROUND LEVEL

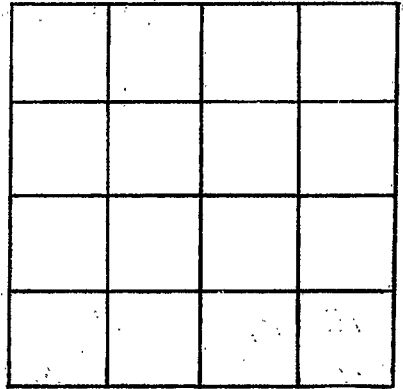

SECTION _____

Please indicate well location X.

ADDITIONAL INFORMATION

If more than one screen,
show locations of each on sketch.