

MISSISSIPPI DEPARTMENT OF NATURAL RESOURCES

Bureau of Land and Water Resources

Southport Mall

P.O. Box 10631

Jackson, Mississippi 39209

WATER WELL DRILLERS LOG

LOWNDES
C 204
8-19-81

8-19 date well completed Clardy Well Drilling firm name Lowndes county well located

LANDOWNER: Dallas Clayton
338A Airbase Rd
Columbus, Miss
(mailing address)

WELL LOCATION:
sec. 17 T. 17 N. R. 18 E
3 1/2 miles no. of Colo.
(distance) (direction) (nearest town)

WELL PURPOSE: home
(home, irrigation, municipal, industrial)

WELL COMPLETION DATA:

(1) diameter (inches) 4"

(2) total depth (feet) 160'

(3) static water level (feet) 16' below top of ground.

(4) casing PVC 65'
(material) (depth)
(size) If telescope see back.

(5) screen 0
(length) (depth to top)
(size) (material)

(6) pump 3/4 1200 gph.
(HP) (yield-gpm)
(type power)

(7) electric log (yes or no)

(organization running log)

(8) how well bottom plugged

description of formations encountered	from to	
Gravel	22	25
Blue Clay	25	47
Sand	47	50
good clay	50	73
sand	73	74
Clay	74	78
Sandy	78	80
good sand	80	87
Clay	87	89
good sand	89	91
Clay	91	92
Sand	92	94
Clay	94	100
sand	100	103
Clay	103	106
sand	106	107
Clay	107	111
sand	111	112
Clay	112	118
sand	118	120
Clay	120	132
sand	132	140
Sandy streaks	140	150
Clay	150	160

DEPT. OF NATURAL RESOURCES
BUREAU OF LAND & WATER RESOURCES


SEP 15 1981

RECEIVED

DRILLERS REMARKS:

If well telescopes please sketch and show depths.


GROUND LEVEL

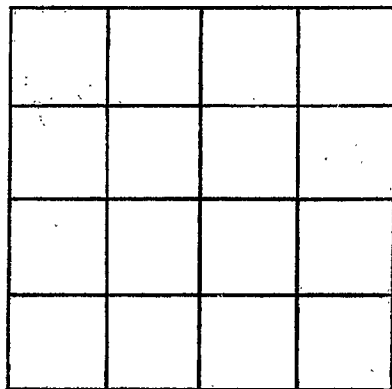

SECTION _____

Please indicate well location X.

ADDITIONAL INFORMATION

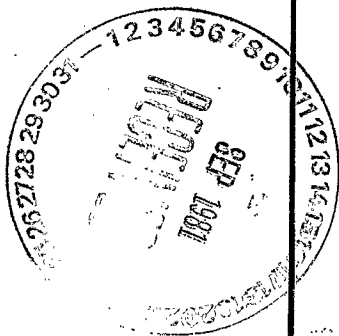

If more than one screen, show locations of each on sketch.