

MISSISSIPPI DEPARTMENT OF NATURAL RESOURCES

Bureau of Land and Water Resources

Southport Mall

P.O. Box 10631

Jackson, Mississippi 39209

WATER WELL DRILLERS LOG

Louder
C 2045
6-26-81

6-26 1981 Clardy Well Drilling Louder
 date well completed firm name county well located

LANDOWNER: Gay Mirra
Wolf Rd.
Columbus, Mo.
 (mailing address)

WELL LOCATION:
 sec. 12 T. 17 N. R. 18 E.
6 miles W of Colo
 (distance) (direction) (nearest town)

WELL PURPOSE: home
 (home, irrigation, municipal, industrial)

WELL COMPLETION DATA:

- (1) diameter (inches) 4"
- (2) total depth (feet) 131'
- (3) static water level (feet) 28 below top of ground.
- (4) casing PVC 99' of 4"
 (material) (depth)
 (size) if telescope see back.
- (5) screen 30'
 (length) (depth to top)
 (size) (material)
- (6) pump 1 1500 gph.
 (HP) (yield gpm)
elec.
 (type power)
- (7) electric log no
 (yes or no)
 (organization running log)
- (8) how well bottom plugged _____

description of formations encountered	from	to
Sand	17	19
Gravel	19	22
Clay	22	24
Sand	24	32
Clay	32	35
Sand	35	38
Clay	38	45
rock	45	
Sand	46	53
Clay	53	56
Sand	56	65
Clay	65	69
rock	69	
sandy streaks	69	71
rock	71	
Clay	72	77
rock's	73	76
Sand	77	78
Sandy Clay	78	80
hard Clay	80	81
rock Clay	81	95
rock's	83	92 1/2
gravel	92 1/2	94
good Clay	94 1/2	120
Sand	120	123
Clay	123	134
Sand	134	135
Clay	135	139
Sand	139	170
Clay	170	174
Sand	174	179
Clay	179	181

MISSISSIPPI DEPARTMENT OF NATURAL RESOURCES
 BUREAU OF LAND & WATER RESOURCES


1111 - 2 1981

RECEIVED

DRILLERS REMARKS: _____

If well telescopes please sketch and show depths.

GROUND LEVEL

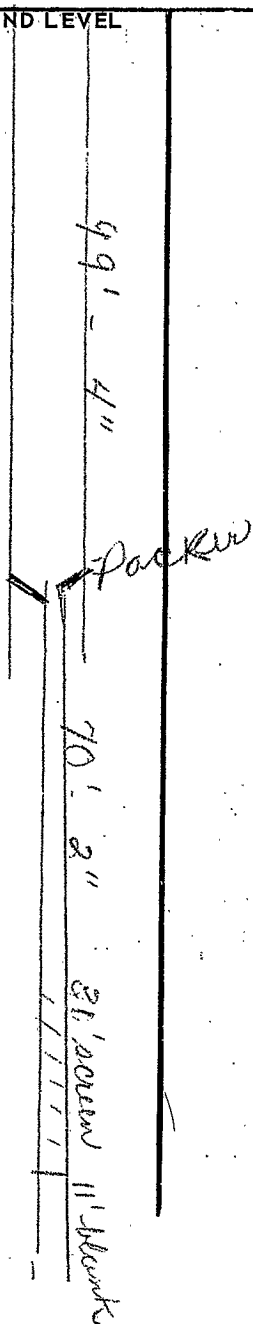

SECTION _____

Please indicate well location X.

ADDITIONAL INFORMATION

If more than one screen, show locations of each on sketch.