

MISSISSIPPI DEPARTMENT OF NATURAL RESOURCES

Bureau of Land and Water Resources

Southport Mall

P.O. Box 10631

Jackson, Mississippi 39209

WATER WELL DRILLERS LOG

<u>Louder</u>
<u>C</u>
<u>2050</u>

1-30
date well completed

1982 Clardy Well Drilling Louder
firm name

county well located

LANDOWNER: Thomson-Martin
3320 One Dallas Centre
Dallas, Tex. 75201
(mailing address)

WELL LOCATION: CAFB
sec. 35 T. 16 N. R. 19 E.
8 miles NW of Colo.
(distance) (direction) (nearest town)

WELL PURPOSE: ind.
(home, irrigation, municipal, industrial)

WELL COMPLETION DATA:


- (1) diameter (inches) 4"
- (2) total depth (feet) 295'
- (3) static water level (feet) 38' below top of ground.
- (4) casing PVC, 143'
(material) (depth)
4"
(size) if telescope see back.
- (5) screen 50'
(length) (depth to top)
2", PVC
(size) (material)
- (6) pump 5 40
(HP) (yield gpm)
elec.
(type power)
- (7) electric log No.
(yes or no)
(organization running log)
- (8) how well bottom plugged
Sand Shark

DRILLERS REMARKS:

description of formations encountered	from	to
sand & gravel	6	36
Clay	36	44
Sandy clay	44	72
Clay	72	98
rock	98	
rock	99 1/2	
good clay	99 1/2	109
rock	109	110 1/2
good clay	110 1/2	113
rock	113	113 1/2
Clay	113 1/2	115
rock	115	116 1/2
Sandy clay	118	140
white clay	140	162 1/2
rock	142 1/2	146
2" rock	146	
Sand	146 1/2	147
sandy clay	147	153 1/2
rock	153 1/2	154 1/2
Clay	154 1/2	156
rock	156	
Clay	156	157 1/2
rock 4"	157 1/2	
Clay (brown)	158	162
Clay	162	169
rock	169	170
Clay	170	172 1/2
sm. rock	172 1/2	
Clay	172 1/2	177 1/2
rock	177 1/2	
sandy clay	177 1/2	179 1/2
rock	179 1/2	181
Clay	181	212
rock	212	214
Clay	214	215 1/2
rock	215 1/2	
Clay	216	217
SAND SHARK	217	
Clay	217	247
Sand	247	260

If well telescopes please sketch and show depths.

GROUND LEVEL

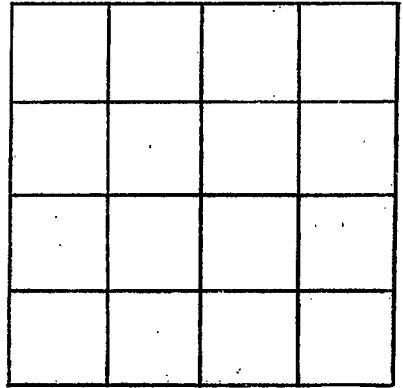

SECTION _____

Please indicate well location X.

ADDITIONAL INFORMATION

If more than one screen,
show locations of each on sketch.