

MISSISSIPPI DEPARTMENT OF NATURAL RESOURCES
 Bureau of Land and Water Resources
 Southport Mall
 P.O. Box 10631
 Jackson, Mississippi 39209
WATER WELL DRILLERS LOG

Lowder
C
2051

3-26 1982 Clardy Well Drilling Lowder
 date well completed Lowder filn name Lowder county well located

LANDOWNER: Hayt Rye
Welfo Rd.
Columbus, Miss.
 (mailing address)

WELL LOCATION:
 sec. 24 T 17 N R 19 E
4 1/2 miles No. of Colo.
 (distance) (direction) (nearest town)

WELL PURPOSE: Home
 (home, irrigation, municipal, industrial)

WELL COMPLETION DATA:

- (1) diameter (inches) 4"
- (2) total depth (feet) 81 1/2
- (3) static water level (feet) 18 below above top of ground.
- (4) casing PVC 5-2'
 (material) (depth)
 _____ if telescope see back.
 (size)
- (5) screen _____
 (length) (depth to top)

 (size) (material)
- (6) pump 1/2 900 gph.
 (HP) (yield gpm)

 (type power)
- (7) electric log _____
 (yes or no)

 (organization running log)
- (8) how well bottom plugged _____


| description of formations encountered | from | to |
|---------------------------------------|--------|--------|
| Sand & gravel | 9 | 32 1/2 |
| clay | 32 1/2 | 47 |
| Sand | 47 | 69 |
| rock. | 49 | |
| Clay | 49 | 53 |
| sand | 53 | 53 1/2 |
| Clay | 53 1/2 | 55 |
| sand 2" | | |
| Clay | 55 | 56 1/2 |
| rocks | 56 1/2 | 59 1/2 |
| Clay | 59 1/2 | 61 1/2 |
| sandy clay | 61 1/2 | 66 |
| Sand | 66 | 67 1/2 |
| Clay | 67 1/2 | 81 1/2 |

DEPT. OF NATURAL RESOURCES
 BUREAU OF LAND & WATER RESOURCES
 APR 5 1982
RECEIVED

DRILLERS REMARKS:

If well telescopes please sketch and show depths.

GROUND LEVEL

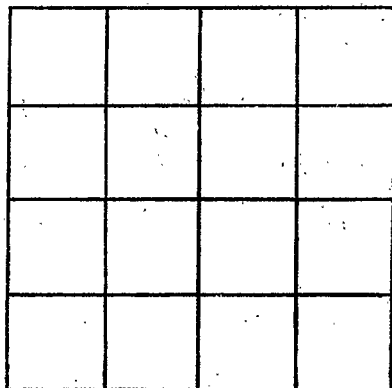

SECTION _____

Please indicate well location X.

ADDITIONAL INFORMATION

If more than one screen,
show locations of each on sketch.