

MISSISSIPPI DEPARTMENT OF NATURAL RESOURCES

Bureau of Land and Water Resources

Southport Mall

P.O. Box 10631

Jackson, Mississippi 39209

WATER WELL DRILLERS LOG

Journal
C
2056

10-22 1982 Clardy Well Drilling Louder
 date well completed firm name county well located

LANDOWNER: Raymond Williams
Wolfe Rd.
Columbus, Ms.
 (mailing address)

WELL LOCATION:
 sec. 24 T 17 N R 18 E
4 1/2 miles no of Colo.
 (distance) (direction) (nearest town)

WELL PURPOSE: Home
 (home, irrigation, municipal, industrial)

WELL COMPLETION DATA:

(1) diameter (inches) 4"

(2) total depth (feet) 82'

(3) static water level (feet) _____ below above top of ground.

(4) casing PVC 55 1/2
 (material) (depth)
 _____ if telescope see back.
 (size)

(5) screen _____
 (length) (depth to top)
 _____ (size) _____ (material)

(6) pump 1/2 800 gph.
 (HP) (yield gpm)
elec
 (type power)

(7) electric log no
 (yes or no)
 _____ (organization running log)

(8) how well bottom plugged _____

description of formations encountered	from	to
Red sandy clay	0	9
rock 3"	9	
Hydrol. clay	9	30
clay	30	45
sandy clay	45	46 1/2
good clay	46 1/2	48 1/2
sandy clay	48 1/2	49 1/2
good clay	49 1/2	50
hard	50	50 1/2
good clay	50 1/2	51
sandy clay	51	51 1/2
good clay	51 1/2	52 1/2
sandy clay	52 1/2	56
good clay	56	59
fine sand	59	62
sand	62	67
sandy clay	67	82

DEPT. OF NATURAL RESOURCES
 BUREAU OF LAND & WATER RESOURCES


NOV 30 1982

RECEIVED

DRILLERS REMARKS:
Pump set 50'

If well telescopes please sketch and show depths.

GROUND LEVEL

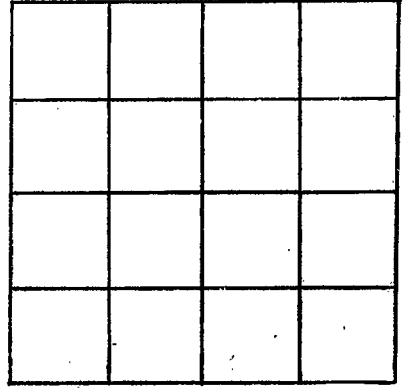

SECTION _____

Please indicate well location X.

ADDITIONAL INFORMATION

If more than one screen,
show locations of each on sketch.