

Lowndes
C
2059

MISSISSIPPI
 BOARD OF WATER COMMISSIONERS
 416 North State Street
 Jackson, Mississippi 39201

WATER WELL DRILLERS LOG

September 10 19 82 Mid South Drilling Co. Lowndes
 date well completed firm name county well located

LANDOWNER: Leon's Construction

610 22nd St. North

Columbus MS 39701
 (mailing address)

description of formations encountered

from to

clay	0	10
sand	10	65

WELL LOCATION:

sec. 26 T 17 S R. 18 W

_____ miles _____ of _____
 (distance) (direction) (nearest town)

WELL PURPOSE: home
 (home, irrigation, municipal, industrial)

WELL COMPLETION DATA:

- (1) diameter (inches) 4"
- (2) total depth (feet) 65'
- (3) static water level (feet) 10' ~~below~~ ~~below~~ below top of ground.
- (4) casing PVC 55'
 (material) (depth)
4"
 (size) if telescope see back.
- (5) screen 10' 55'
 (length) (depth to top)
.032 PVC
 (size) (material)
- (6) pump 1/2 10
 (HP) (yield gpm)

 (type power)
- (7) electric log no
 (yes or no)
none
 (organization running log)
- (8) how well bottom plugged screen

DEPT. OF NATURAL RESOURCES
 BUREAU OF LAND & WATER RESOURCES


OCT 26 1982

DRILLERS REMARKS:

RECEIVED

If well telescopes please sketch and show depths.

GROUND LEVEL

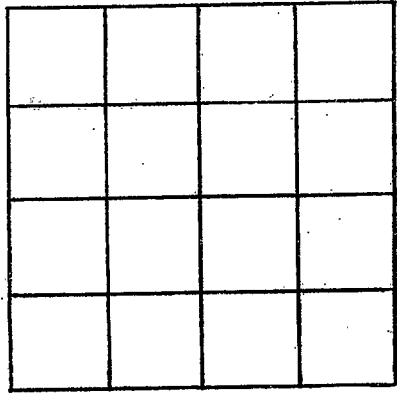

SECTION _____

Please indicate well location X.

ADDITIONAL INFORMATION

Lined area for providing additional information, consisting of approximately 20 horizontal lines.

If more than one screen, show locations of each on sketch.