

Lowndes
C
2060

MISSISSIPPI
 BOARD OF WATER COMMISSIONERS
 416 North State Street
 Jackson, Mississippi 39201
 WATER WELL DRILLERS LOG

September 9 19 82 Mid South Drilling Lowndes
 date well completed firm name county well located

LANDOWNER: Leon's Construction 610 22nd St. North Columbus, MS 39701 (mailing address)	description of formations encountered	from	to
	XXXX clay	0	11
	sand & gravel	11	65
WELL LOCATION:			
sec. <u>26</u> T. <u>17</u> N. S. R. <u>18</u> E. W.			
_____ miles _____ of _____ (distance) (direction) (nearest town)			
WELL PURPOSE: home (home, irrigation, municipal, industrial)			
WELL COMPLETION DATA:			
(1) diameter (inches) <u>XXX</u> 4"			
(2) total depth (feet) <u>65</u> '			
(3) static water level (feet) <u>10</u> ' above below top of ground.			
(4) casing <u>PVC</u> <u>55</u> (material) (depth) <u>4</u> " (size) if telescope see back.			
(5) screen <u>10</u> ' <u>55</u> ' (length) (depth to top) <u>.032</u> <u>PVC</u> (size) (material)			
(6) pump <u>1/2</u> <u>10</u> (HP) (yield gpm) <u>electric</u> (type power)			
(7) electric log <u>no</u> (yes or no) <u>no</u> (organization running log)			
(8) how well bottom plugged <u>screen</u>			
DRILLERS REMARKS:			


DEPT. OF NATURAL RESOURCES
 BUREAU OF LAND & WATER RESOURCES

OCT 26 1982

RECEIVED

If well telescopes please sketch and show depths.

GROUND LEVEL

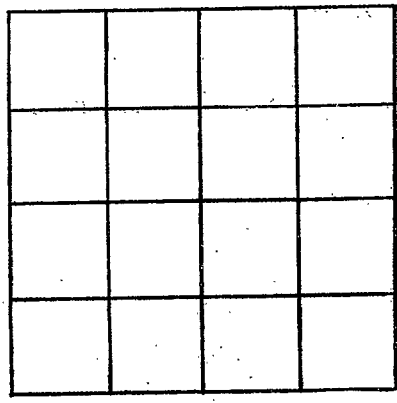

SECTION _____

Please indicate well location X.

ADDITIONAL INFORMATION

A series of horizontal lines for entering additional information.

If more than one screen, show locations of each on sketch.