

MISSISSIPPI DEPARTMENT OF NATURAL RESOURCES
BUREAU OF LAND & WATER RESOURCES

Southport Mall
P.O. Box 10631

JAN 28 1983

Jackson, Mississippi 39209

WATER WELL DRILLERS RECEIVED


Landowner
C
2062

11/25 1982 Clardy Hill Drilling Lowndes
date/well completed firm name county well located

LANDOWNER:	description of formations encountered	from	to
James King	Clay	0	13
P.O. Box 462	blue clay	13	26
Columbus, Miss.	sandy clay	26	28
(mailing address)	rock	28	29
WELL LOCATION:	Sandy clay	29	55 1/2
sec. 29 T 17 N R 18 E	rock	55 1/2	57
1 1/2 miles No. of Cobs.	Sandy clay	57	60
(distance) (direction) (nearest town)	rock	60	60 1/2
WELL PURPOSE:	Sandy clay	60 1/2	100
(home, irrigation, municipal, industrial)	rock	100	101
WELL COMPLETION DATA:	Sandy clay	101	104
(1) diameter (inches) 4"	good clay	104	113
(2) total depth (feet) 315'	sandy clay	113	116
(3) static water level (feet) 93 ^{below} _{ground}	rock	116	116 1/2
(4) casing PVC, 153' (material) (depth)	Sandy clay	116 1/2	123
(size) if telescope see back.	rock	123	125
(5) screen (length) (depth to top)	Sandy clay	125	133
(size) (material)	rock	133	134
(6) pump 3/4 (HP) 800 gpm (yield gpm)	good clay	134	137
(type power)	Gummy clay	137	141
(7) electric log (yes or no)	fine clay	141	147
(organization running log)	rock	147	147 1/2
how well bottom plugged	good clay	147 1/2	176
and 2/7/83	fine sand	176	184
DRILLERS REMARKS:	good blue clay	184	192
	Sandy clay	192	206
	fine sand	206	207
	Sandy clay	207	213
	fine sand	213	218
	Sandy clay	218	231
	good clay	231	239
	rock	239	239 1/2
	Sandy clay	239 1/2	247
	hard clay	247	263
	Sandy clay	263	274
	fine sand	274	283
	Sandy clay	283	299
	Sandy	299	312
	rock	312	313
	hard clay	313	315

If well telescopes please sketch and show depths.

GROUND LEVEL

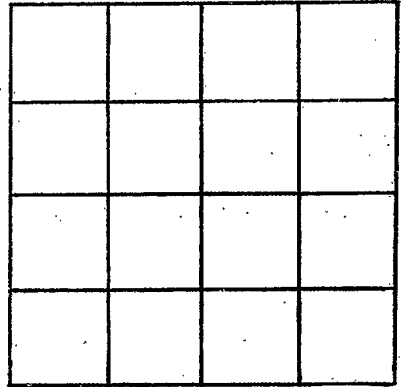

SECTION _____

Please indicate well location X.

ADDITIONAL INFORMATION

If more than one screen, show locations of each on sketch.