

MISSISSIPPI DEPARTMENT OF NATURAL RESOURCES

Bureau of Land and Water Resources

Southport Mall

P.O. Box 10631

Jackson, Mississippi 39209

WATER WELL DRILLERS LOG

TOM GRIFFITH

PLUMBING & WELL SERVICE, INC.

320 MAYSON AVE.

COLUMBIA, MS 39429

Lownds  
C  
2066

June 1 1983 date well completed Lownds county well located

LANDOWNER: John Wofford  
Rt. 1  
Columbus, MS  
(mailing address)

description of formations encountered	from	to
sand & gravel	0	40
chalk	40	50
rock	50	53
chalk	53	130
sand	130	150

WELL LOCATION:  
sec. 23 T. 12 N. R. 18 E.  
4 miles N of Columbus  
(distance) (direction) (nearest town)

WELL PURPOSE: home  
(home, irrigation, municipal, industrial)

WELL COMPLETION DATA:

(1) diameter (inches) 4"

(2) total depth (feet) 150'

(3) static water level (feet) 20 below above top of ground.

(4) casing PVC, 130'  
(material) (depth)  
N/A if telescope see back.  
(size)

(5) screen 20', 130'  
(length) (depth to top)  
3", PVC  
(size) (material)

(6) pump 1/2, 13  
(HP) (yield gpm)  
electric  
(type power)

(7) electric log none  
(yes or no)  
(organization running log)

(8) how well bottom plugged bwu

DRILLERS REMARKS:


DEPT. OF NATURAL RESOURCES  
BUREAU OF LAND & WATER RESOURCES

JUL 25 1983

RECEIVED

If well telescopes please sketch and show depths.

GROUND LEVEL

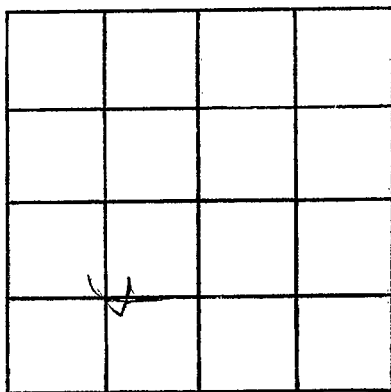

SECTION 23

Please indicate well location X.

ADDITIONAL INFORMATION

If more than one screen,  
show locations of each on sketch.