

Lowndes  
 C. 2067

MISSISSIPPI DEPARTMENT OF NATURAL RESOURCES  
 Bureau of Land and Water Resources  
 Southport Mall  
 P.O. Box 10631  
 Jackson, Mississippi 39209  
**WATER WELL DRILLERS LOG**

date well completed 19

firm name

county well located

LANDOWNER:	description of formations encountered	from	to
(mailing address)			
WELL LOCATION:	Clay	283	296
sec. _____ T _____ N _____ S _____ R _____ E _____ W _____	Sandy Clay	296	299
_____ miles _____ of _____ (distance) (direction) (nearest town)	rocky soft Clay	299	305
WELL PURPOSE:	Hard Clay	305	316
(home, irrigation, municipal, industrial)	Soft Clay	316	320
WELL COMPLETION DATA:	rock	320	320
(1) diameter (inches) _____	Sandy Clay	320	330
(2) total depth (feet) _____	Hard Sandy Clay	330	340
(3) static water level (feet) _____ below above top of ground.	Sandy Hard Clay	340	341
(4) casing _____ (material) ' _____ (depth) ' _____ If telescope see back. (size)	Sandy rock	341	370
(5) screen _____ (length) ' _____ (depth to top) _____ (size) ' _____ (material)	Sandy - hard	370	400
(6) pump _____ (HP) _____ (yield gpm) _____ (type power)	Sandy Clay streaks	400	417
(7) electric log _____ (yes or no) _____ (organization running log)	Clay	417	425
(8) how well bottom plugged _____	Sandy	425	434
DRILLERS REMARKS:	sandy	434	435
	Sandy	435	443
	Clay	443	445
	sandy & rocky	445	457
	Clay	457	460
	sandy & rocky	460	462
	white Clay	462	463


DEPT. OF NATURAL RESOURCES  
 BUREAU OF LAND & WATER RESOURCES

OCT 31 1983


RECEIVED

if well telescopes please sketch and show depths.

GROUND LEVEL

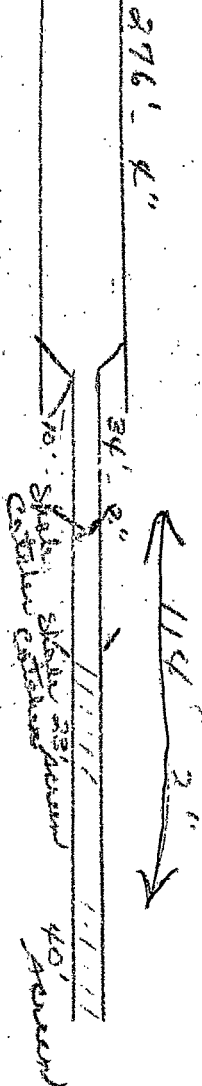

If more than one screen, show locations of each on sketch.

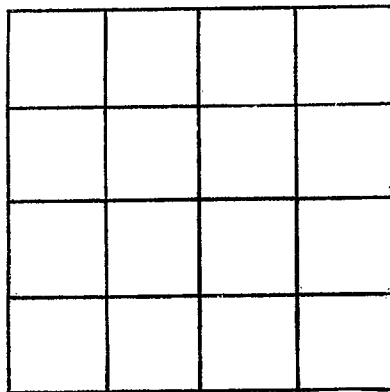

SECTION \_\_\_\_\_

Please indicate well location X.

ADDITIONAL INFORMATION

Additional information section with horizontal lines for text entry.