

MISSISSIPPI DEPARTMENT OF NATURAL RESOURCES

Bureau of Land and Water Resources

Southport Mall

P.O. Box 10631

Jackson, Mississippi 39209

WATER WELL DRILLERS LOG

Louder
C.
2068

10-10 date well completed Clardy Well Drilling Louder firm name Clardy County well located

LANDOWNER: Mike. Lavender
Ridge Rd.
Columbus, Miss.
 (mailing address)

WELL LOCATION:
 sec. 34 T. 17 N. R. 18 E.
1/2 miles N of Col.
 (distance) (direction) (nearest town)

WELL PURPOSE: home
 (home, irrigation, municipal, industrial)

WELL COMPLETION DATA:

(1) diameter (inches) 4"

(2) total depth (feet) 281'

(3) static water level (feet) 83' below above top of ground.

(4) casing PVC 148'
 (material) (depth)
4" if telescope see back.
 (size)

(5) screen 31'
 (length) (depth to top)
2" PVC
 (size) (material)

(6) pump 3/4 1200gph.
 (HP) (yield gpm)
elec.
 (type power)

(7) electric log no
 (yes or no)

(organization turning top) DEC 1983

(8) how well bottom plugged RECEIVED

DRILLERS REMARKS: _____

description of formations encountered	from	to
red sandy clay	0	72
sandy blue clay	72	80
good clay	80	82
sandy clay	82	96
good clay	96	101
sandy clay	101	128
good clay	128	129 1/2
rock (10 1/2")	129 1/2	
rock (13")	132	
rock (14")	133 1/2	
good clay	134	136 1/2
rock	136 1/2	
rock	137 1/2	
good clay	138 1/2	146
rock	146	
good clay	146	164
rock	164	
lime sand	164	173
sandy clay	173	179 1/2
sand	179 1/2	180 1/2
clay	180 1/2	193
sandy clay	193	194
clay	194	196 1/2
rock (1")	196 1/2	
sandy clay	196 1/2	197 1/2
rock	197 1/2	
sandy clay	197 1/2	202
rock, sandy clay	202	206
sandy clay	206	209
rock (6")	209	
clay	209 1/2	210 1/2
rock (6")	210 1/2	
clay	215	217
rock (2")	217	
clay	217	219
rock 1"	219	
sandy clay	219	222
rock, sandy clay	222	238 1/2
lime sand	238 1/2	246
sand	246	259 1/2
clay	259 1/2	281

If well telescopes please sketch and show depths.


GROUND LEVEL

148' - 4" casing

148' - 6" sand screen

148' - 6" sand screen

If more than one screen, show locations of each on sketch.

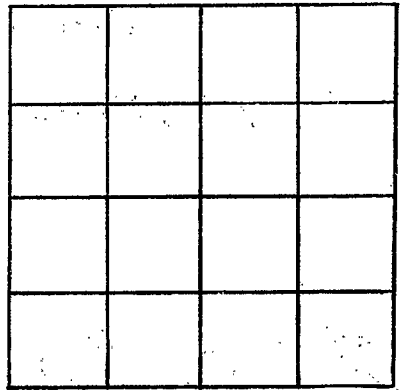

SECTION _____

Please indicate well location X.

ADDITIONAL INFORMATION

Multiple horizontal lines for additional information.