

MISSISSIPPI DEPARTMENT OF NATURAL RESOURCES

Bureau of Land and Water Resources

Southport Mall

P.O. Box 10631

Jackson, Mississippi 39209

WATER WELL DRILLERS LOG

Landowner
C
2069

11-18 1983 Clardy Well Drilling Landowners
 date well completed film name county well located

LANDOWNER: Colbert Realty
101 Main St.
Columbus, Miss.
 (mailing address)

WELL LOCATION:
 sec. 3 T. 17 N. R. 18 E
7 miles No. of Colo.
 (distance) (direction) of (nearest town)

WELL PURPOSE:
 (home, irrigation, municipal, industrial)

WELL COMPLETION DATA:
 (1) diameter (inches) 4"
 (2) total depth (feet) 130'
 (3) static water level (feet) 18' below/above top of ground.
 (4) casing PVC 101'-6"
 (material) (depth)
 if telescope see back.
 (5) screen 17'-2" 2" PVC
 (length) (depth to top) (size) (material)
 (6) pump 1/2 850 gpm
 (HP) (yield gpm)
elec
 (type power)
 (7) electric log no
 (yes or no)
 (organization running log)

description of formations encountered	from	to
Brown Clay	0	13 1/2
Sand & gravel	13 1/2	29 1/2
rock (4")	29 1/2	31 1/2
blue clay	31 1/2	63 1/2
sm. rock (4")	63 1/2	63 1/2
Clay (8 1/2")	63 1/2	67
sm. rock	67	67
Clay (11 1/2")	67	71
sandy clay	71	78 1/2
Clay	78 1/2	79 1/2
sand	79 1/2	80 1/2
Clay	80 1/2	83 1/2
sand	83 1/2	88
sandy clay	88	95
Clay	95	98
sand	98	98 1/2
Clay	98 1/2	103
sand	103	109
Clay	109	113 1/2
sandy clay	113 1/2	124
Clay	124	125
Sand & gravel	125	130


DEPT. OF NATURAL RESOURCES
 BUREAU OF LAND & WATER RESOURCES

DEC - 7 1983

RECEIVED

DRILLERS REMARKS:

If well telescopes please sketch and show depths.

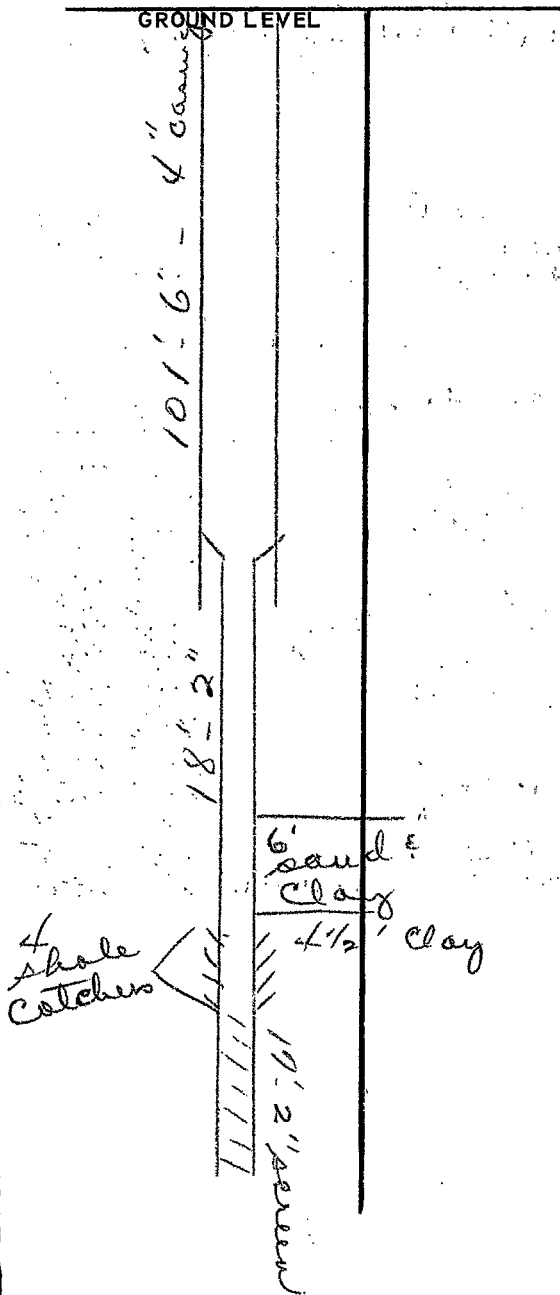

SECTION _____

Please indicate well location X.

ADDITIONAL INFORMATION

If more than one screen, show locations of each on sketch.