

MISSISSIPPI DEPARTMENT OF NATURAL RESOURCES

Bureau of Land and Water Resources

Southport Mall

P.O. Box 10631

Jackson, Mississippi 39209

WATER WELL DRILLERS LOG

Counties
C
2071

1/12 date well completed Clardy Well Drilling firm name Louisa county well located

LANDOWNER: Corn Coast
167 S. McCrary
Colo. Ms.
 (mailing address)

WELL LOCATION:
 sec. 28 T. 17 N. R. 18 E.
2 miles No of Colo.
 (distance) (direction) (nearest town)

WELL PURPOSE: Municipal
 (home, irrigation, municipal, industrial)

WELL COMPLETION DATA:

(1) diameter (inches) 4"

(2) total depth (feet) 346'

(3) static water level (feet) 94' below above top of ground.

(4) casing PVC 156'
 (material) (depth)
4" if telescope see back.
 (size)

(5) screen _____
 (length) (depth to top)
 (size) (material)

(6) pump 3/4 900 gpl.
 (HP) (yield gpm)
elec.
 (type power)

(7) electric log no
 (yes or no)
 (organization running log)

(8) how well bottom plugged _____

description of formations encountered	from	to
red sandy clay	0	18
sandy blue clay	18	138 1/2
sm. rock	138 1/2	
sandy clay	138 1/2	142
sm. rock	142	
sandy clay	142	145
sm. rock	145	
sandy clay	145	146
sm. rock	146	
sandy clay	146	147 1/2
sm. rock	147 1/2	
sandy clay	147 1/2	150
sm. rock	150	
sm. rock	150 1/2	
fine clay	150 1/2	158 1/2
sm. rock	158 1/2	
clay	158 1/2	175
sandy clay	175	179 1/2
sm. rock	179 1/2	
good clay	179 1/2	196
sm. rock	196	
good clay	196	207
sandy clay	207	211
rock 6"	211	
clay	211 1/2	222
rock	222	
clay	222	245 1/2
rock 1"	245 1/2	
sandy clay	245 1/2	249 1/2
sm. rock	249 1/2	
sandy clay	249 1/2	262
hard clay	262	272
sandy clay	272	312
sm. rock	312	
DEPT. OF NATURAL RESOURCES	312	346
BUREAU OF LAND & WATER RESOURCES		


DRILLERS REMARKS:

MAR - 1 1984

RECEIVED

If well telescopes please sketch and show depths.

GROUND LEVEL

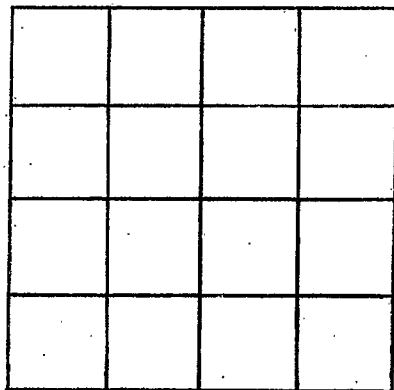

SECTION _____

Please indicate well location X.

ADDITIONAL INFORMATION

If more than one screen,
show locations of each on sketch.