

MISSISSIPPI DEPARTMENT OF NATURAL RESOURCES

Bureau of Land and Water Resources

Southport Mall

P.O. Box 10631

Jackson, Mississippi 39209

WATER WELL DRILLERS LOG

Lowndes
C 2072

7-9-84, Clardy Well Drilling Lowndes
date well completed firm name county well located

LANDOWNER: Conn Const.
167 S. Mc Cravy
Colo. MS.
(mailing address)

WELL LOCATION:
sec. 29 T. 17 N. R. 18 E.
1 1/2 miles No of Colo.
(distance) (direction) (nearest town)

WELL PURPOSE: Home
(home, irrigation, municipal, industrial)

WELL COMPLETION DATA:

(1) diameter (inches) 4"

(2) total depth (feet) 320 1/2

(3) static water level (feet) 77' below top of ground.

(4) casing PVC, 175' (material) (depth)
(size) if telescope see back.

(5) screen _____ (length) _____ (depth to top)
(size) _____ (material)

(6) pump 3/4 1000 gph. (HP) (yield gpm)
elec. (type power)

(7) electric log no (yes or no)
(organization running log)

(8) how well bottom plugged _____

description of formations encountered	from	to
Red sandy clay	0	24
sandy blue clay	24	28
rock	28	28 1/2
sandy blue clay	28 1/2	65 1/2
rock	65 1/2	66 1/2
sandy clay	66 1/2	140
good clay	140	218
sand	218	220
hard clay	220	245
sand	245	249
hard clay	249	267
sand	267	275
hard clay	275	287
sand	287	305 1/2
rock	305 1/2	307
sand	307	320 1/2
rock	320 1/2	


DEPT. OF NATURAL RESOURCES
BUREAU OF LAND & WATER RESOURCES

SEP - 4 1984
RECEIVED

DRILLERS REMARKS: _____

If well telescopes please sketch and show depths.

GROUND LEVEL

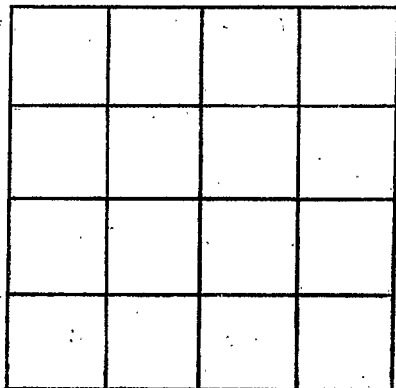

SECTION _____

Please indicate well location X.

ADDITIONAL INFORMATION

If more than one screen,
show locations of each on sketch.