

MISSISSIPPI DEPARTMENT OF NATURAL RESOURCES

Bureau of Land and Water Resources

Southport Mall

P.O. Box 10631

Jackson, Mississippi 39209

WATER WELL DRILLERS LOG

Lowndes
C 2074

10-11

19

Clardy Well Drilling Lowndes
 firm name county well located

LANDOWNER: Sam O'Quinn

description of formations encountered

from

to

Rt 5 Box 141
Columbus, Miss.
 (mailing address)

| | | |
|-------------------|-----|-----|
| Brown Clay | 0 | 14 |
| gravel | 14 | 43 |
| red clay & gravel | 43 | 50 |
| sandy yellow clay | 50 | 58 |
| good clay | 58 | 71 |
| sandy clay | 71 | 85 |
| rock | 85 | 88 |
| good clay | 88 | 104 |
| sandy clay | 104 | 114 |
| spud | 114 | 131 |
| Clay | 129 | 131 |
| rock | 131 | |

WELL LOCATION:

sec. 3 T. 17 N. R. 18 E.
7 miles 16 of Col.
 (distance) (direction) (nearest town)

WELL PURPOSE: home

(home, irrigation, municipal, industrial)

WELL COMPLETION DATA:

- (1) diameter (inches) 4"
 (2) total depth (feet) 131'
 (3) static water level (feet) 18' below top of ground.

- (4) casing PVC, 91'
 (material) (depth)
 (size) If telescope see back.

- (5) screen 30'
 (length) (depth to top)
2" PVC
 (size) (material)

- (6) pump 1/2 900 gph.
 (HP) (yield-gpm)
elec
 (type power)

- (7) electric log No
 (yes or no)
 (organization running log)

- (8) how well bottom plugged _____

DRILLERS REMARKS:

DEPT. OF NATURAL RESOURCES
 BUREAU OF LAND & WATER RESOURCES

NOV 29 1984


RECEIVED

If well telescopes please sketch and show depths.

GROUND LEVEL

117-116

10' 2" screen

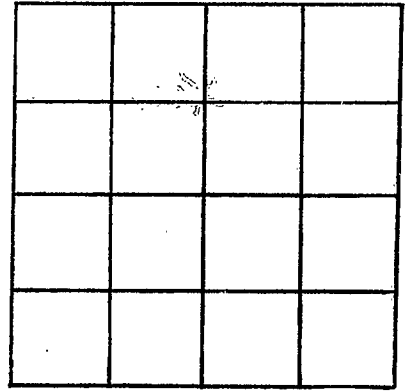

SECTION _____

Please indicate well location X.

ADDITIONAL INFORMATION

If more than one screen, show locations of each on sketch.