

MISSISSIPPI DEPARTMENT OF NATURAL RESOURCES

Bureau of Land and Water Resources

Southport Mall

P.O. Box 10631

Jackson, Mississippi 39209

WATER WELL DRILLERS LOG

Townler  
C 275

10-18 1984 Clardy Well Drilling Services Louisa  
 date well completed firm name county well located

LANDOWNER Pat Wingel  
Hwy 12  
Colo. 775  
 (mailing address)

WELL LOCATION:  
 sec 35 T 17 N R 18 E  
1 1/2 miles no of Colo.  
 (distance) (direction) (nearest town)

WELL PURPOSE: home  
 (home, irrigation, municipal, industrial)

WELL COMPLETION DATA:

(1) diameter (inches) 4"

(2) total depth (feet) 169'

(3) static water level (feet) \_\_\_\_\_ below above top of ground.

(4) casing PVC 93'  
 (material) (depth)  
4" if telescope see back.  
 (size)

(5) screen 30' PVC  
 (length) (depth to top)  
2" (size) (material)

(6) pump \_\_\_\_\_ (HP) \_\_\_\_\_ (yield gpm)  
 (type power)

(7) electric log \_\_\_\_\_ (yes or no)  
 (organization running log)

(8) how well bottom plugged \_\_\_\_\_

description of formations encountered	from	to
sand	0	9
gravel	9	13
sandy clay	13	16
hard clay	16	28 1/2
ROCK	28 1/2	29
sandy clay	29	31 1/2
ROCK	31 1/2	32
good clay	32	112 1/2
rock	112 1/2	119
hard clay	119	122 1/2
rock (2")	122 1/2	128
hard clay	128	135
rock	135	141
sandy clay	141	143
hard clay	143	167
sand	167	169
Clay		

DEPT. OF NATURAL RESOURCES  
 BUREAU OF LAND & WATER RESOURCES

NOV 29 1984

RECEIVED


DRILLERS REMARKS:

If well telescopes please sketch and show depths.

GROUND LEVEL

Handwritten notes and sketches in the left column, including a vertical line and the text "30' screen".

If more than one screen, show locations of each on sketch.

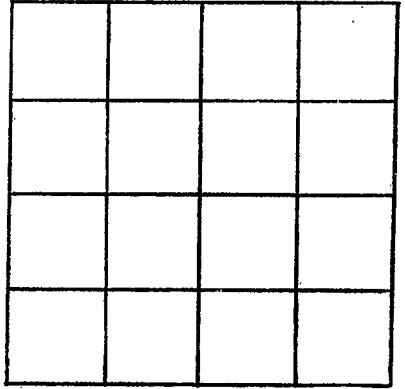

SECTION \_\_\_\_\_

Please indicate well location X.

ADDITIONAL INFORMATION

Lined area for additional information.