

MISSISSIPPI DEPARTMENT OF NATURAL RESOURCES

Bureau of Land and Water Resources

Southport Mall

P.O. Box 10631

Jackson, Mississippi 39209

WATER WELL DRILLERS LOG

C 2076
Lowndes
2-4-85

2-4-85 date well completed 19 Clardy Well Drilling Lowndes firm name county well located

LANDOWNER James McShaw
Airbase Rd.
Columbus, MS.
(mailing address)

description of formations encountered	from	to
Brown Clay	0	9
Sand & gravel	9	26
Sandy Clay	26	55
good blue clay	55	164
sand	164	182
rock 2"		
Clay	182	188
sand	188	200 1/2
rock 6"	200 1/2	201
Clay	201	202

WELL LOCATION:
sec. 8 T 17 N R 18 E
5 miles N of Columbus, MS.
(distance) (direction) (nearest town)

WELL PURPOSE: Farm
(home, irrigation, municipal, industrial)

- WELL COMPLETION DATA:
- (1) diameter (inches) 4"
 - (2) total depth (feet) 202'
 - (3) static water level (feet) 30' below top of ground.
 - (4) casing (material) PVC, (depth) 87'
 - (size) 4" if telescope see back.
 - (5) screen (length) 30', (depth to top) 57'
 - (size) 2", (material) PVC
 - (6) pump (HP) 1/2, (yield gph) 900 gph.
 - (type power) elec.
 - (7) electric log no (yes or no)
 - (organization running log)
 - (8) how well bottom plugged


RECEIVED
APR 2 - 1985

Department of Natural Resources
Bureau of Land & Water Resources


DRILLERS REMARKS:

If well telescopes please sketch and show depths.

GROUND LEVEL

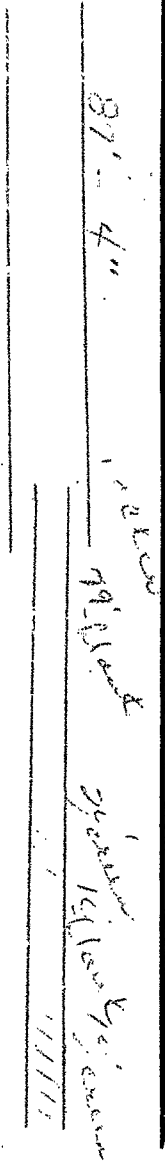

WELL

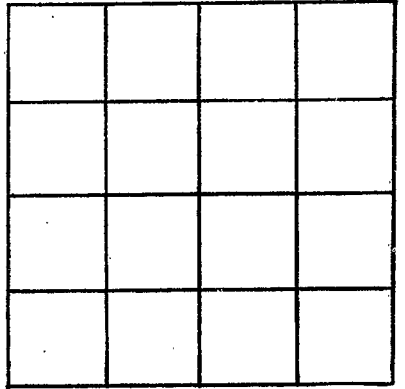

SECTION _____

Please indicate well location X.

ADDITIONAL INFORMATION

Blank lines for additional information.

If more than one screen, show locations of each on sketch.