

MISSISSIPPI DEPARTMENT OF NATURAL RESOURCES

Bureau of Land and Water Resources

Southport Mall

P.O. Box 10631

Jackson, Mississippi 39209

WATER WELL DRILLERS LOG

C 2077
 Lowndes
 2-15-85

2-15-85 date well completed 19 Clardy Well Drilling firm name Lowndes county well located

LANDOWNER: Flora L. LeRott
airbase Rd.
Columbus, Ms.
 (mailing address)

WELL LOCATION:
 sec. 8 T 17 N R. 18 E
5 miles no. of Col.
 (distance) (direction) (nearest town)

WELL PURPOSE: home
 (home, irrigation, municipal, industrial)

WELL COMPLETION DATA:

- (1) diameter (inches) 4"
- (2) total depth (feet) 202'
- (3) static water level (feet) 30' below top of ground.
- (4) casing PVC 87'
 (material) (depth)
4"
 (size) if telescope see back.
- (5) screen 30 (length) (depth to top)
2" PVC
 (size) (material)
- (6) pump 1/2 (HP) 900 gph (yield gph)
elec.
 (type power)
- (7) electric log no (yes or no)
 (organization running log)
- (8) how well bottom plugged _____

description of formations encountered	from	to
Brown clay	0	14
sand & gravel	14	29
sandy clay	29	60
good clay	60	155
sandy clay	155	160
sand	160	169 1/2
rock 6"		
sand	170	179
clay	179	182
rock 2"		
clay	182	190
shell	190	199
clay	199	203

RECEIVED


APR 2 - 1985

Department of Natural Resources
 Bureau of Land & Water Resources


DRILLERS REMARKS: _____

If well telescopes please sketch and show depths.

GROUND LEVEL

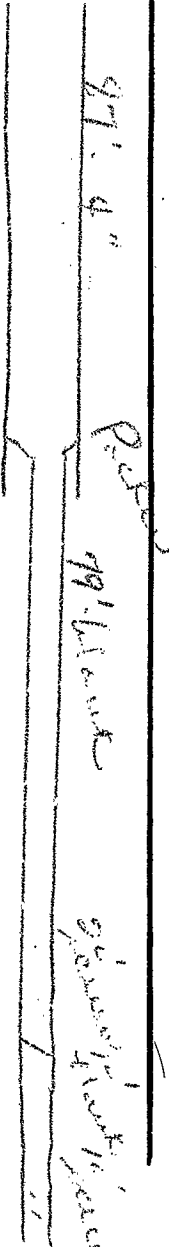

If more than one screen, show locations of each on sketch.

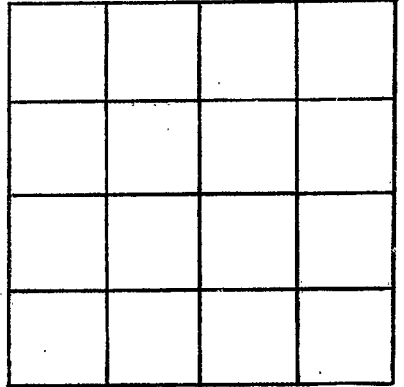

SECTION _____

Please indicate well location X.

ADDITIONAL INFORMATION

Horizontal lines for additional information.