

**MISSISSIPPI DEPARTMENT OF NATURAL RESOURCES**  
**Bureau of Land and Water Resources**  
 Southport Mall  
 P.O. Box 10631  
 Jackson, Mississippi 39209  
**WATER WELL DRILLERS LOG**

Lowndes  
C 2078  
4-18-85

L

April 18, 1985 19 Mid South Drilling Company Lowndes  
 date well completed firm name county well located

**LANDOWNER:** Jim Wamble  
Industrial Specialty Company  
P. O. Box 2446  
Columbus, MS 39701  
 (mailing address)

description of formations encountered	from	to
clay	0-	10
sand	10	15
clay	15	45
clay and sand	45	90
clay	90	165
clay and sand	165	285
sand	285	315

**WELL LOCATION:**  
 sec. 34 T. 17 S. R. 18 W.  
1 miles NE of Columbus  
 (distance) (direction) (nearest town)

**WELL PURPOSE:** home  
 (home, irrigation, municipal, industrial)

- WELL COMPLETION DATA:**
- (1) diameter (inches) 4"
  - (2) total depth (feet) 315'
  - (3) static water level (feet) 100' ~~below~~ top of ground.
  - (4) casing PVC 212'  
 (material) (depth)  
4" if telescope see back.  
 (size)
  - (5) screen none  
 (length) (depth to top)  
 (size) (material)
  - (6) pump none  
 (HP) (yield gpm)  
 (type power)
  - (7) electric log no  
 (yes or no)  
none  
 (organization running log)
  - (8) how well bottom plugged open


**RECEIVED**  
 JUL 19 1985

**DRILLERS REMARKS:**

Department of Natural Resources  
 Bureau of Land & Water Resources

If well telescopes please sketch and show depths.

GROUND LEVEL

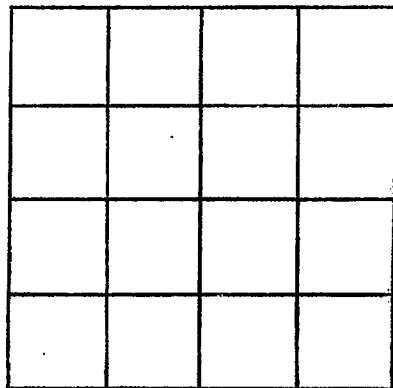

SECTION \_\_\_\_\_

Please indicate well location X.

ADDITIONAL INFORMATION

If more than one screen,  
show locations of each on sketch.