

MISSISSIPPI DEPARTMENT OF NATURAL RESOURCES

Bureau of Land and Water Resources

Southport Mall

P.O. Box 10631

Jackson, Mississippi 39209

WATER WELL DRILLERS LOG

Lowndes
C 2082

September 25, 1985 Mid-South Drilling Lowndes
date well completed firm name county well located

LANDOWNER: George Tennill
Columbus Miss 39701
(mailing address)

description of formations encountered

from to

sand	0	15
clay	15	45
sand + clay	45	135
	135	165
	165	295

WELL LOCATION:
sec. 27 T. 17 N R. 18 E
3/4 miles North of Columbus
(distance) (direction) (nearest town)

WELL PURPOSE: home
(home, irrigation, municipal, industrial)

WELL COMPLETION DATA:

(1) diameter (inches) 4"

(2) total depth (feet) 295'

(3) static water level (feet) _____ below above top of ground.


(4) casing PVC, 255'
(material) (depth)
4" if telescope see back.
(size)

(5) screen 40', 265'
(length) (depth to top)
2" PVC
(size) (material)

(6) pump _____ (HP) _____ (yield gpm)
(type power)

(7) electric log _____ (yes or no)
(organization running log)

(8) how well bottom plugged _____

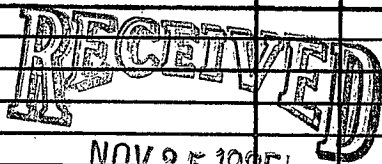


NOV 25 1985

DRILLERS REMARKS:

Department of Natural Resources
Bureau of Land & Water Resources

If well telescopes please
sketch and show depths.

GROUND LEVEL

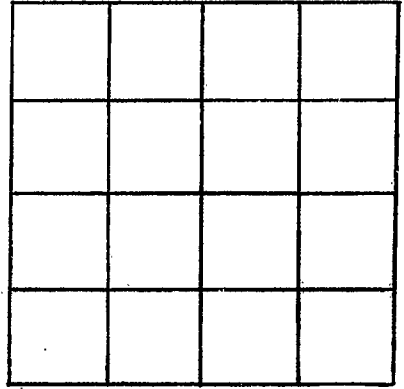

SECTION _____

Please indicate well location X.

ADDITIONAL INFORMATION

If more than one screen,
show locations of each on sketch.