

MISSISSIPPI DEPARTMENT OF NATURAL RESOURCES

Bureau of Land and Water Resources

Southport Mall

P.O. Box 10631

Jackson, Mississippi 39209

WATER WELL DRILLERS LOG

LOWNDES  
C 2083

1-15-86 date well completed  
Clardy Well Drilling Lowndes firm name  
county well located

LANDOWNER: Curtis Gore  
2506 21st Ave No.  
Columbus, Miss.  
(mailing address)

WELL LOCATION:  
sec. 9 T 17 N R 18 E  
5 miles No. of Colo.  
(distance) (direction) (nearest town)

WELL PURPOSE: Home  
(home, irrigation, municipal, industrial)

- WELL COMPLETION DATA:
- (1) diameter (inches) 4"
  - (2) total depth (feet) 186'
  - (3) static water level (feet) 30' below top of ground.
  - (4) casing PVC 74'  
(material) (depth)  
4" if telescope see back.  
(size)
  - (5) screen 40'  
(length) (depth to top)  
2" PVC  
(size) (material)
  - (6) pump 3/4 1000  
(HP) (yield gpm) gph.
  - (7) electric log No  
(yes or no)
  - (organization running log)
  - (8) how well bottom plugged


description of formations encountered	from	to
clay	0	12
sandy gravel	12	31
sandy blue clay	31	57 1/2
soft blue clay	57 1/2	62
rock 6"	62	
streaks - rock & blue clay	62	79
good blue clay	79	81
sandy blue clay	81	101
sand	101	106 1/2
rock 6"		
sand	107	108
good sand	110	123
rock 6"		
clay	123	129
good sand	129	130
blue clay	130	139
brown clay	139	172
streaks - sand & rocks	172	182
brown clay	182	186

RECEIVED  
MAR 2 - 1986

Mississippi Department of Natural Resources  
Bureau of Land & Water Resources

DRILLERS REMARKS:

If well telescopes please sketch and show depths.

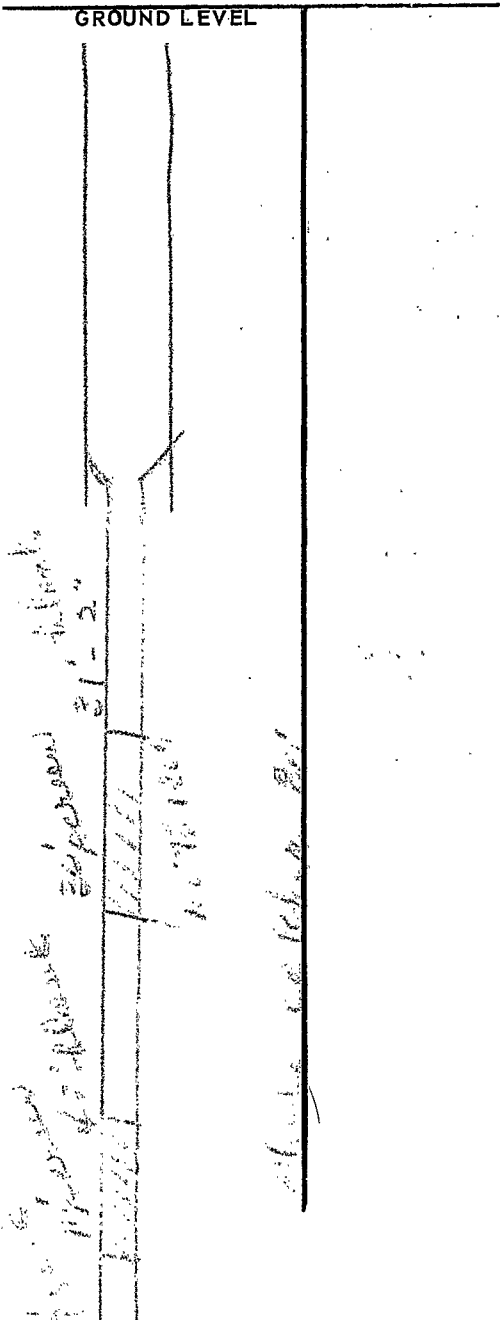


SECTION \_\_\_\_\_

Please indicate well location X.

**ADDITIONAL INFORMATION**

---

---

If more than one screen, show locations of each on sketch.