

MISSISSIPPI DEPARTMENT OF NATURAL RESOURCES

Bureau of Land and Water Resources

Southport Mall

P.O. Box 10631

Jackson, Mississippi 39209

WATER WELL DRILLERS LOG

LANDOWNERS
C
2084

8-17-86 19 Churdy well Drilling Landover date well completed firm name county well located

LANDOWNER: Dr. Yalowitz
3623 Azalea Circle
Columbus, MS -
 (mailing address)

WELL LOCATION:
 sec. 29 T 17 N R 18 E
1 1/2 miles No. of Colo.
 (distance) (direction) (nearest town)

WELL PURPOSE: Domestic
 (home, irrigation, municipal, industrial)

WELL COMPLETION DATA:

(1) diameter (inches) 4"

(2) total depth (feet) 313'

(3) static water level (feet) 80 1/2 below top of ground.

(4) casing PVC, 160'
 (material) (depth)
4" If telescope see back.
 (size)

(5) screen 28', (depth to top)
2" PVC
 (size) (material)

(6) pump 1 (HP) (yield gpm)
elec
 (type power)

(7) electric log no
 (yes or no)


(8) no how well bottom plugged

description of formations encountered	from	to
Red clay	0	5
sandy silty clay	5	19
am. rock	0	
sandy clay	18	30
rock (4")		
sandy clay	30	61 1/2
sandy silt - rock	61 1/2	63
sandy clay	63	68
am. rock		
sandy clay	68	101 1/2
rock	101 1/2	102
sandy clay	102	110 1/2
am. rock		
sandy clay	110 1/2	112 1/2
am. rock	1	
sandy clay	112 1/2	123
am. rock		
sandy clay	123	128 1/2
rock	128 1/2	134
sandy clay	134	137
clay	137	138 1/2
am. rock		
sandy clay	138	139
am. rock		
sandy clay	139	143 1/2
am. rock		
sandy clay	143 1/2	146
am. rock		
sandy clay	146	148
am. rock		
sandy clay	148	156
am. rock		
sandy clay	156	164
clay (am. rock)	160	196
am. rock		
sandy clay	176	181 1/2
broken shell	181 1/2	201 1/2
am. rock	201 1/2	210
sandy clay	210	212
sandy clay	212	225
sandy clay	227	228
am. rock		
clay	228	237

RECEIVED
 DRILLERS REMARKS:
8-2-1986

If well telescopes please sketch and show depths.

GROUND LEVEL

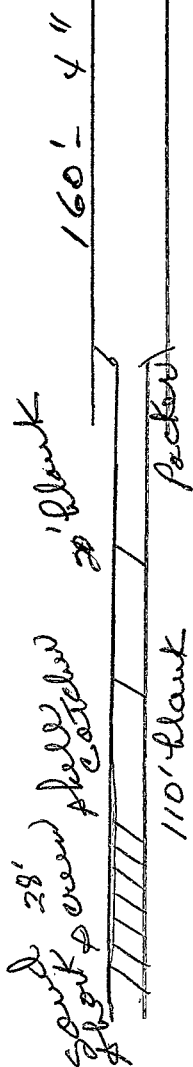

SECTION _____

Please indicate well location X.

ADDITIONAL INFORMATION

~~hard rock~~
gummy clay 237-241
~~hard rock~~
sandy clay 241-242 1/2
arg. rock
clay 242 1/2 - 245 1/2
~~arg. rock~~
hard clay 245 1/2 - 254 1/2
sandy clay 254 1/2 - 264 1/2
hard clay 264 1/2 - 267
sandy clay 267 - 271 1/2
hard clay 271 1/2 - 287
sandy clay 287 - 290
fine sand 290 - 310 1/2
hard clay 310 1/2 - 313

If more than one screen, show locations of each on sketch.