

**MISSISSIPPI DEPARTMENT OF NATURAL RESOURCES**  
**Bureau of Land and Water Resources**  
 Southport Mall  
 P.O. Box 10631  
 Jackson, Mississippi 39209  
**WATER WELL DRILLERS LOG**

Lowndes  
C 2089

7-21-87 date well completed      19 Mid South Drilling Company firm name      Lowndes county well located

LANDOWNER: Contractor John Holliman Construction Rt. 1	description of formations encountered	from	to
Steens, MS 39766 (mailing address)	clay sand	0 14	14 20
<b>WELL LOCATION:</b> sec. <u>11</u> T <u>17</u> N R <u>18</u> E 6 miles N of Columbus (distance) (direction) (nearest town)	sand & gravel clay sand clay <del>XX</del> clay w/ sand streaks	20 39 40 46 55	39 40 46 55 65
<b>WELL PURPOSE:</b> home (home, irrigation, municipal, industrial)	clay sand	65 84	84 89
<b>WELL COMPLETION DATA:</b>	<del>XXXXX</del> clay	89	105
(1) diameter (inches) <u>4"</u>	sand & clay	105	111
(2) total depth (feet) <u>168</u>	clay	111	128
(3) static water level (feet) <u>40</u> below top of ground.	sand	135	142
(4) casing <u>PVC</u> <u>111</u> (material) (depth) <u>4"</u> (size) if telescope see back.	clay snad	142 145	145 168
(5) screen <u>none</u> (length) (depth to top) (size) (material)			
(6) pump <u>1/2</u> <u>10</u> (HP) (yield gpm) <u>electric</u> (type power)			
(7) electric log <u>no</u> (yes or no) <u>none</u> (organization running log)			
(8) how well bottom plugged <u>open</u>			
<b>DRILLERS REMARKS:</b>			


**RECEIVED**

OCT 26 1987

Department of Natural Resources  
 Bureau of Land & Water Resources

If well telescopes please  
sketch and show depths.

GROUND LEVEL

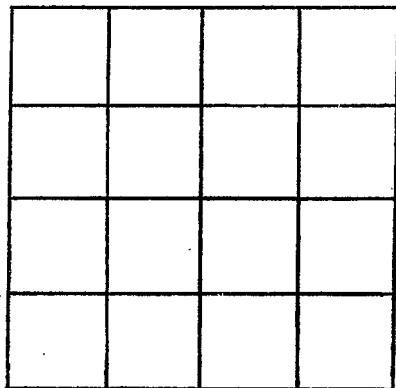

SECTION \_\_\_\_\_

Please indicate well location X.

ADDITIONAL INFORMATION

If more than one screen,  
show locations of each on sketch.