

MISSISSIPPI DEPARTMENT OF NATURAL RESOURCES

Bureau of Land and Water Resources

P.O. Box 10631

Jackson, Mississippi 39209

WATER WELL DRILLERS LOG

COUNTY WELL LOCATED Summers	
WELL NUMBER C 2092	CODED
DATE WELL COMPLETED 9/2/88	

PERMIT NUMBER
NAME OF DRILLING FIRM Clardy Well, Drilling Columbus, Miss.

NAME & MAILING ADDRESS OF LANDOWNER Billo Davis			
403 3rd Ave. S.			
Columbus, Miss. 39701			
WELL LOCATION: SEC	TOWNSHIP	RANGE	
16	17	N 18 E	
DISTANCE	DIRECTION	NEAREST TOWN	
4 1/2 Miles	North of	Columbus	
OTHER LANDMARK			
WELL PURPOSE: Home, Irrigation, Municipal, Industrial, Fish Pond, etc. Home			

PUMP DATA		
PUMP TYPE (Circle One): <input checked="" type="checkbox"/> Submersible <input type="checkbox"/> Turbine <input type="checkbox"/> Jet <input type="checkbox"/> Flowing Well, Other (Describe) _____		
POWER TYPE (Circle One): <input checked="" type="checkbox"/> Electric <input type="checkbox"/> Tractor, Diesel, Gasoline, Butane, Other (Describe) _____		
Pump Capacity (GPM)	No. of Stages	Setting Depth
800	9	100 FT.
PUMP TEST		
Well yielded 800 GPM with a drawdown of _____ ft. after _____ hours of pumping		

WELL DATA		
Well Depth 195	Casing Diameter (In.) 4"	Casing Length (Ft.) 105
Type of Casing PVC	Hole Depth	Depth to Static Water Level 17'
TYPE OF COMPLETION: (Circle One or More): <input type="checkbox"/> Gravel Packed, <input type="checkbox"/> Underreamed, <input type="checkbox"/> Telescoped, <input type="checkbox"/> Natural Development, <input type="checkbox"/> Open Hole, <input type="checkbox"/> Other (Describe) _____		
Top of Lap Pipe or Reduction in Casing		
FEET IF TELESCOPED OR MORE THAN ONE SCREEN: USE BACK PAGE		

LOG DATA	
TYPE OF LOG RUN (Circle One): <input type="checkbox"/> No Log Run, <input type="checkbox"/> Electric, <input type="checkbox"/> Gamma Ray, <input type="checkbox"/> Density, <input type="checkbox"/> Sonic, <input type="checkbox"/> Neutron, Other (Describe) _____	
Name of Organization Running Log	

SCREEN DATA		
Diameter - Inches	Length - Feet	Slot Size - Inches
Screen Type	Depth to Bottom - Feet	


GEOLOGIC DATA (Office Use Only)			
Surface Elev.	Geologic Unit	Unit Thickness	Depth to Top
Subs. SWL	Date	Analysis	Qualifier Test
Driller's Remarks SEP 19 1988			
Department of Natural Resources Bureau of Land & Water Resources			

DESCRIPTION OF FORMATIONS ENCOUNTERED	FROM	TO	FORMATIONS (Continued)	FROM	TO
White clay	0	9	Clay	105	112
Sand + gravel	9	23	Small rock	112	
Blue clay	23	30	Clay	112	138
Sandy clay	30	76	Soft rock	138	138 1/2
Blue clay	76	79	Clay	138 1/2	143
Sandy clay	79	80	(Rock)	143	144
Clay	80	81	Clay	144	158 1/2
Sandy clay	81	93	Sm rock	158 1/2	
Clay	93	101	Clay	158 1/2	161
Small rock	101		Small rock	161	
Sandy clay	101	105			

IF MORE SPACE IS NEEDED, USE BACK

If well telescopes please sketch and show depths.

GROUND LEVEL

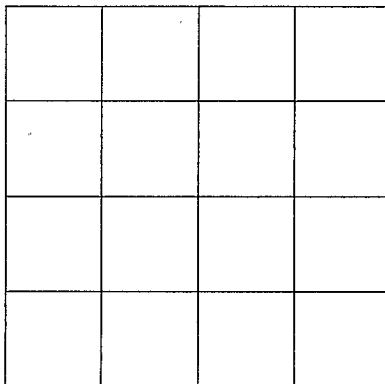

SECTION _____

Please indicate well location X.

ADDITIONAL INFORMATION

Clay	161 - 166 1/2
(Rock)	166 1/2 - 168 1/2
Sandy clay	168 1/2 - 171 1/2
Sm. rock	171 1/2 - 172
Sandy clay	172 - 175 1/2
Clay	175 1/2 - 177 1/2
Sandy clay	177 1/2 - 180
Clay	180 - 181 1/2
Sandy clay	181 1/2 - 184
Sm. rock	184
Sandy clay	184 - 187
Soft rock	187 - 188
Hummocky clay	188 - 192
Red clay	192 - 195

If more than one screen, show location of each on sketch.