

MISSISSIPPI DEPARTMENT OF NATURAL RESOURCES

Bureau of Land and Water Resources

COUNTY WELL LOCATED
Monroe

WELL NUMBER **C 2093** CODED

DATE WELL COMPLETED
8/26/88

PERMIT NUMBER

NAME OF DRILLING FIRM
**Clardy Well Drill
Columbus, Mo.**

P.O. Box 10631
Jackson, Mississippi 39209
WATER WELL DRILLERS LOG

NAME & MAILING ADDRESS OF LANDOWNER
**Thomas Morgan
Rt. 9 Box 391
Columbus, Mo. 39701**

WELL LOCATION: SEC **22** TOWNSHIP **17 N** RANGE **18 E**

DISTANCE **3** Miles DIRECTION **North** NEAREST TOWN **Columbus**

OTHER LANDMARK
Fish pond

WELL PURPOSE: Home, Irrigation, Municipal, Industrial, Fish Pond, etc.
Fish pond

PUMP DATA

PUMP TYPE (Circle One):
 Submersible, Turbine, Jet Flowing Well,
Other (Describe) _____

POWER TYPE (Circle One):
 Electric, Tractor, Diesel, Gasoline, Butane,
Other (Describe) _____

Pump Capacity (GPM) **900** No. of Stages **9** Setting Depth **100** FT.

PUMP TEST
Well yielded **900** GPM with
a drawdown of _____ ft.
after _____ hours of pumping

WELL DATA

Well Depth 175	Casing Diameter (In.) 4"	Casing Length (Ft.) 102
Type of Casing PVC	Hole Depth 14'	Depth to Static Water Level 14'

TYPE OF COMPLETION: (Circle One or More):
Gravel Packed, Underreamed, Telescoped,
Natural Development, Open Hole, Other
(Describe) _____

Top of Lap Pipe or Reduction in Casing
FEET IF TELESCOPED OR MORE THAN ONE SCREEN: USE BACK PAGE

LOG DATA

TYPE OF LOG RUN (Circle One): No Log Run,
 Electric, Gamma Ray, Density, Sonic, Neutron,
Other (Describe) _____

Name of Organization Running Log

SCREEN DATA

Diameter - inches	Length - Feet	Slot Size - Inches
Screen Type	Depth to Bottom - Feet	

GEOLOGIC DATA (Office Use Only)

Surface Elev.	Geologic Unit	Unit Thickness	Depth to Top
Subs. SWL	Date	Analysis	Adular Test

REGISTRY

SEP 19 1988


Department of Natural Resources
Bureau of Land & Water Resources

DESCRIPTION OF FORMATIONS ENCOUNTERED	FROM	TO	FORMATIONS (Continued)	FROM	TO
White sandyl.	0	18	Clay	79	84
Gravel	18	25	sm rock	84	84 1/2
sandy blue clay	25	46	Clay	84 1/2	87 1/2
Blue clay	46	51 1/2	sm rock	87 1/2	
sm rock	51 1/2		Clay	87 1/2	94
Clay	51 1/2	58	sm rock	94	
sandy clay	58	61 1/2	Clay	94	98
Clay	61 1/2	63	sm rock	98	
sandy clay	63	70	Clay	98	101
Clay	70	72	sm rock	101	
sandy clay	72	79			

IF MORE SPACE IS NEEDED, USE BACK

If well telescopes please sketch and show depths.

GROUND LEVEL

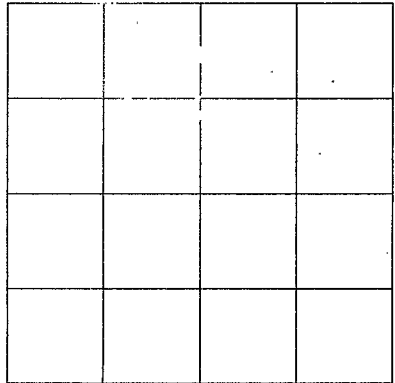

SECTION _____

Please indicate well location X.

ADDITIONAL INFORMATION

Clay	101 - 104
Sandy clay	104 - 110
Clay	110 - 114
Sandy clay	114 - 114 1/2
Clay	114 1/2 - 119
Sandy clay	119 - 120
Sand streak	120 - 126
Coarse sandy cl.	126 - 144
Clay	144 - 148
Sandy clay	148 - 162
Hummy blue cl.	162 - 175

If more than one screen,
show location of each on sketch.