

MISSISSIPPI DEPARTMENT OF NATURAL RESOURCES

Bureau of Land and Water Resources

P.O. Box 10631

Jackson, Mississippi 39209

WATER WELL DRILLERS LOG

COUNTY WELL LOCATED Douglas	
WELL NUMBER C 2094	CODED
DATE WELL COMPLETED 3/10/89	

PERMIT NUMBER
NAME OF DRILLING FIRM Clardy Well Drill Columbus, Mo.

NAME & MAILING ADDRESS OF LANDOWNER Tommy Yeatman Holly Hill Rd. Columbus, Mo. 39101			
WELL LOCATION: SEC	TOWNSHIP	RANGE	
32	17 N	18 E	
DISTANCE 3/4 Miles	DIRECTION North	NEAREST TOWN Columbus	
OTHER LANDMARK Home			
WELL PURPOSE: Home, Irrigation, Municipal, Industrial, Fish Pond, etc. Home			

PUMP DATA		
PUMP TYPE (Circle One): <input checked="" type="checkbox"/> Submersible Turbine Jet Flowing Well, Other (Describe) _____		
POWER TYPE (Circle One): <input checked="" type="checkbox"/> Electric Tractor, Diesel, Gasoline, Butane, Other (Describe) _____		
Pump Capacity (GPM) 900	No. of Stages 12	Setting Depth 160 FT.
PUMP TEST Well yielded 900 GPM [#] with a drawdown of _____ ft. after _____ hours of pumping		

WELL DATA		
Well Depth 244	Casing Diameter (In.) 4"	Casing Length (Ft.) 186'
Type of Casing PVC	Hole Depth	Depth to Static Water Level 115'
TYPE OF COMPLETION: (Circle One or More): <input type="checkbox"/> Gravel Packed, <input type="checkbox"/> Underreamed, <input type="checkbox"/> Telescoped, <input type="checkbox"/> Natural Development, <input type="checkbox"/> Open Hole, <input type="checkbox"/> Other (Describe) _____		
Top of Lap Pipe or Reduction in Casing FEET IF TELESCOPED OR MORE THAN ONE SCREEN: USE BACK PAGE		

LOG DATA	
TYPE OF LOG RUN (Circle One): No Log Run, Electric, Gamma Ray, Density, Sonic, Neutron, Other (Describe) _____	
Name of Organization Running Log	


SCREEN DATA		
Diameter - Inches 2"	Length - Feet 50'	Slot Size - Inches .013
Screen Type PVC	Depth to Bottom - Feet	

GEOLOGIC DATA (Office Use Only)			
Surface Elev. _____	Geologic Unit _____	Unit thickness _____	Depth to Top _____
Subs. SW _____	Date _____	Analysis _____	Aquifer Test _____
Driller's Remarks APR 25 1989			
Department of Natural Resources Bureau of Land & Water Resources			

DESCRIPTION OF FORMATIONS ENCOUNTERED	FROM	TO	FORMATIONS (Continued)	FROM	TO
Red clay	0	14	Sandy clay	149	158
Sand	14	30	Clay & rocky streak	158	163
Sandy red clay	30	35	Sandy clay	163	167
Sandy blue clay	35	45	Clay	167	174
Rock	45	45 1/2	Rock	174	174 1/2
Sandy clay	45 1/2	64	Sandy clay	174 1/2	201
Rock	64	64 1/2	Fine sand	201	213
Sandy clay	64 1/2	138 1/2	Sand. streak	213	228
Clay	138 1/2	139 1/2	Clay	228	230
Sandy clay	139 1/2	148 1/2	Sand. streak	230	240
Clay	148 1/2	149			

IF MORE SPACE IS NEEDED, USE BACK

If well telescopes please sketch and show depths.

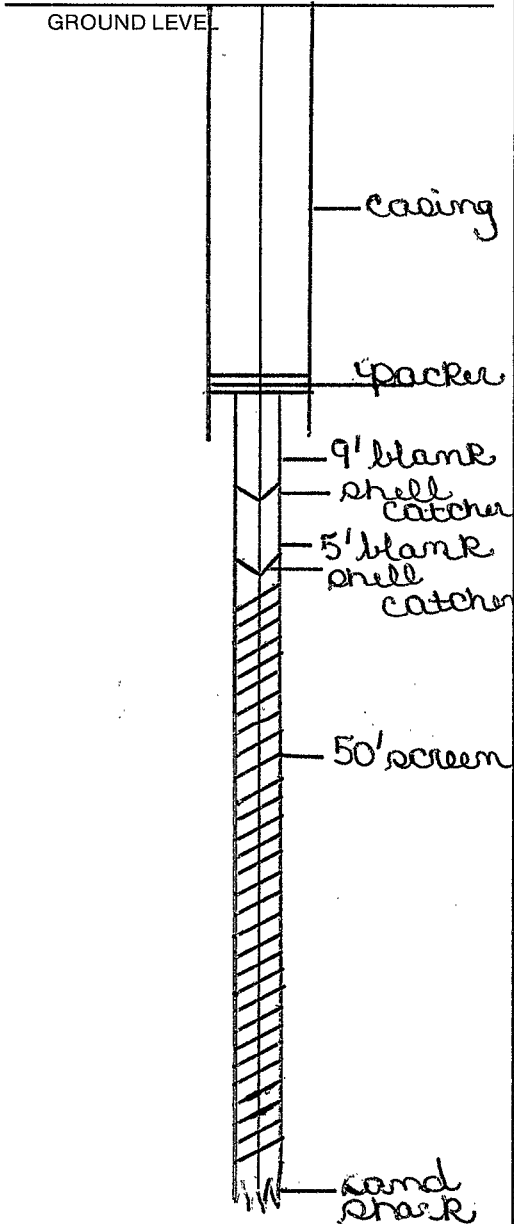

SECTION _____

Please indicate well location X.

ADDITIONAL INFORMATION

Clay 240-244

If more than one screen, show location of each on sketch.