

MISSISSIPPI DEPARTMENT OF NATURAL RESOURCES
Bureau of Land and Water Resources

P.O. Box 10631
Jackson, Mississippi 39209
WATER WELL DRILLERS LOG

COUNTY/WELL LOCATED LOWDNES	
WELL NUMBER C 2096	CODED
DATE WELL COMPLETED 1-15-87	

PERMIT NUMBER N/A
NAME OF DRILLING FIRM Skanden Well & Supply Hanner, Mrs

NAME & MAILING ADDRESS OF LANDOWNER Dr. Wiley Hutchins			
2459 5th St North			
Columbus			
WELL LOCATION: SEC	TOWNSHIP	RANGE	
27	12	N	18
DISTANCE 1 Miles		DIRECTION NE	NEAREST TOWN Columbus
OTHER LANDMARK			
WELL PURPOSE: <input checked="" type="checkbox"/> Home Irrigation <input type="checkbox"/> Municipal, Industrial, Fish Pond, etc. Home & yard			

PUMP DATA		
PUMP TYPE (Circle One): <input checked="" type="checkbox"/> Submersible Turbine Jet Flowing Well, Other (Describe) _____		
POWER TYPE (Circle One): <input checked="" type="checkbox"/> Electric Tractor Diesel Gasoline Butane, Other (Describe) 2HP		
Pump Capacity (GPM) 18	No. of Stages 18	Setting Depth 210' FT.
PUMP TEST		
Well yielded _____ GPM with a drawdown of _____ ft. after _____ hours of pumping		

WELL DATA		
Well Depth 330	Casing Diameter (In.) 5"	Casing Length (Ft.) 240
Type of Casing STEEL	Hole Depth 330	Depth to Static Water Level 131'
TYPE OF COMPLETION: (Circle One or More): Gravel Packed, Underreamed, <input checked="" type="checkbox"/> Telescoped, Natural Development, Open Hole Other		
Top of Lap Pipe or Reduction in Casing 218' FEET		
IF TELESCOPED OR MORE THAN ONE SCREEN: USE BACK PAGE		

LOG DATA	
TYPE OF LOG RUN (Circle One): Electric, Gamma Ray, Density, Sonic, <input checked="" type="checkbox"/> No Log Run, Neutron, Other (Describe) _____	
Name of Organization Running Log	

SCREEN DATA		
Diameter - Inches 2 1/2	Length - Feet 20'	Slot Size - Inches .010
Screen Type SS	Depth to Bottom - Feet 322	

GEOLOGIC DATA (Office Use Only)			
Surface Elev.	Geologic Unit	Unit Thickness	Depth to Top
Subs. SWL	Date	Analysis	Aquifer Test

Driller's Remarks


DESCRIPTION OF FORMATIONS ENCOUNTERED	FROM	TO	FORMATIONS (Continued)	FROM	TO
Red sandy clay	0	20			
tight red sand	20	30			
red sand	30	105			
tight blue sand w/clay	105	170			
Blue rock	170	225			
tight sand w/clay	225	302			
sand	302	325			
tight sand w/clay	325	333			

RECEIVED
SEP 29 1985
Department of Natural Resources
Bureau of Land & Water Resources

IF MORE SPACE IS NEEDED, USE BACK

If well telescopes please
sketch and show depths.

GROUND LEVEL

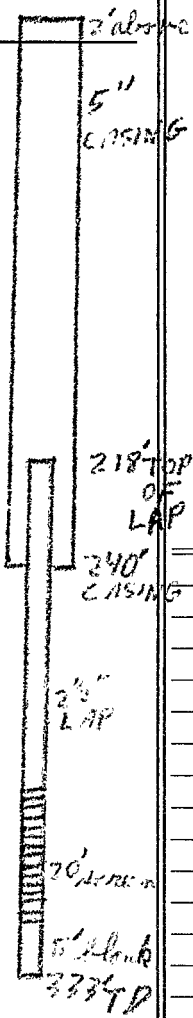

SECTION _____

Please indicate well location X.

ADDITIONAL INFORMATION

If more than one screen,
show location of each on sketch.