

Lauder
C 2112

MISSISSIPPI
 BOARD OF WATER COMMISSIONERS
 416 North State Street
 Jackson, Mississippi 39201

WATER WELL DRILLERS LOG

7-6 1982 Mark S. Kelly Lauder
 date well completed firm name county well located

LANDOWNER:	description of formations encountered	from	to
<u>Depth Well Service</u> <u>10 Airline Mfg. Co.</u> <u>Columbus, MS. 39701</u> (mailing address)	<u>Gravel</u>	<u>0</u>	<u>48</u>
	<u>Blue clay</u>	<u>48</u>	<u>80</u>
	<u>Blue clay sand</u>	<u>80</u>	<u>100</u>
WELL LOCATION: sec. <u>25</u> T <u>17</u> N R <u>17</u> E S W <u>3</u> miles <u>NW</u> of <u>Columbus</u> (distance) (direction) (nearest town)			
WELL PURPOSE: <u>irrigation</u> (home, irrigation, municipal, industrial)			
WELL COMPLETION DATA:			
(1) diameter (inches) <u>4</u>			
(2) total depth (feet) <u>100</u>			
(3) static water level (feet) <u>15</u> below top of ground. above			
(4) casing <u>PVC, 90'</u> (material) (depth) <u>4</u> if telescope see back. (size)			
(5) screen <u>None</u> (length) (depth to top) (size) (material)			
(6) pump <u>3/4</u> <u>12</u> (HP) (yield gpm) <u>1/2</u> (type power)			
(7) electric log <u>NO</u> (yes or no) (organization running log)			
(8) how well bottom plugged <u>open</u>			
DRILLERS REMARKS: <u>70' Surf</u> <u>6" PVC</u>			


DEPT. OF NATURAL RESOURCES
 BUREAU OF LAND & WATER RESOURCES

JUL 14 1982

RECEIVED

If well telescopes please sketch and show depths.

GROUND LEVEL

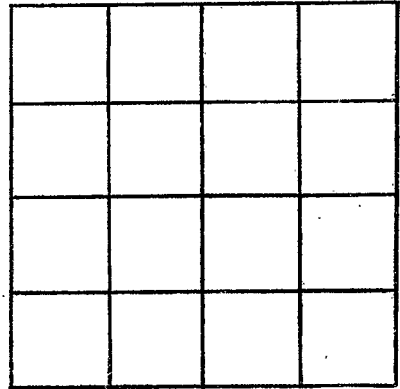

SECTION _____

Please indicate well location X.

ADDITIONAL INFORMATION

If more than one screen, show locations of each on sketch.