

**MISSISSIPPI DEPARTMENT OF ENVIRONMENTAL QUALITY**  
Bureau of Land and Water Resources

P. O. Box 10631  
Jackson, MS 39289-0631  
**WATER WELL DRILLERS LOG**

COUNTY WELL LOCATED <i>Lauderdale</i>	
WELL NUMBER <i>C 2116</i>	CODED
DATE WELL COMPLETED <i>6-21-94</i>	

PERMIT NUMBER <i>0-50.9</i>
NAME OF DRILLING FIRM <i>Ross Drilling</i>

NAME & MAILING ADDRESS OF LANDOWNER <i>A-one Ready mix</i>			
<i>P.O. Box 2403</i>			
<i>Columbus ms. 39704</i>			
WELL LOCATION:	SEC	TOWNSHIP	RANGE
	<i>3</i>	<i>17S</i>	<i>N 18 W</i>
DISTANCE	DIRECTION	NEAREST TOWN	
OTHER LANDMARK <i>South end of Air Base</i>			
WELL PURPOSE: Home, Irrigation, Municipal, Industrial, Fish Pond, etc.			


<b>PUMP DATA</b>		
PUMP TYPE (Circle One): <input checked="" type="radio"/> Submersible, <input type="radio"/> Turbine, <input type="radio"/> Jet, <input type="radio"/> Flowing Well, Other (Describe) _____		
POWER TYPE (Circle One): <input checked="" type="radio"/> Electric, <input type="radio"/> Tractor, <input type="radio"/> Diesel, <input type="radio"/> Gasoline, <input type="radio"/> Butane, Other (Describe) _____ H/P <i>1</i>		
Pump Capacity (GPM)	No. of Stages	Setting Depth
<i>20</i>		<i>120 FT.</i>
<del>PUMP TEST</del>		
<del>Well yielded _____ GPM with</del>		
<del>a drawdown of _____ ft.</del>		
<del>after _____ hours of pumping</del>		

<b>WELL DATA</b>		
Well Depth <i>195'</i>	Casing Diameter (In.) <i>4"</i>	Casing Length (Ft.)
Type of Casing <i>Pvc</i>	Hole Depth	Depth to Static Water Level. <i>10'</i>
TYPE OF COMPLETION: (Circle One or More): <input checked="" type="radio"/> Gravel Packed, <input type="radio"/> Underreamed, <input type="radio"/> Telescoped, <input type="radio"/> Natural Development, <input type="radio"/> Open Hole, <input type="radio"/> Other (Describe) _____		
Top of Lap Pipe or Reduction in Casing		
FEET		
IF TELESCOPED OR MORE THAN ONE SCREEN: USE BACK PAGE		

<b>LOG DATA</b>	
TYPE OF LOG RUN (Circle One): <input type="radio"/> No Log Run, <input type="radio"/> Electric, <input type="radio"/> Gamma Ray, <input type="radio"/> Density, <input type="radio"/> Sonic, <input type="radio"/> Neutron, Other (Describe) <i>none</i>	
Name of Organization Running Log <i>none</i>	


<b>SCREEN DATA</b>		
Diameter - Inches <i>4"</i>	Length - Feet	Slot Size - Inches
Screen Type	Depth to Bottom - Feet	

<b>GEOLOGIC DATA (Office Use Only)</b>			
Surface Elev.	Geologic Unit	Unit Thickness	Depth to Top
Subs. SWL	Date	Analysis	Aquifer Test
Driller's Remarks			

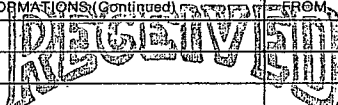DESCRIPTION OF FORMATIONS ENCOUNTERED	FROM	TO	FORMATIONS (Continued) FROM	TO
<i>Clay</i>	<i>0</i>	<i>26</i>	 <b>MAY 26 1995</b>	
<i>Sandstone gravel</i>	<i>26</i>	<i>40</i>		
<i>Blue clay sand sh</i>	<i>40</i>	<i>130</i>		
<i>Sandy sh &amp; Blue cl</i>	<i>130</i>	<i>195</i>		
Dept. of Environmental Quality Office of Land & Water Resources				
IF MORE SPACE IS NEEDED, USE BACK				

If well telescopes please  
sketch and show depths.

GROUND LEVEL

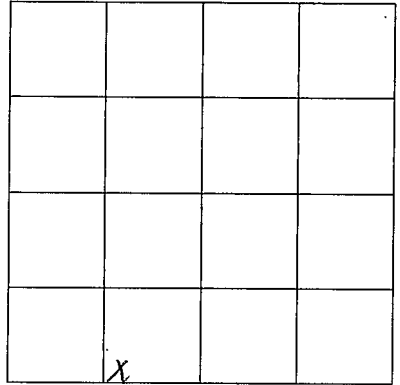

SECTION 5

Please indicate well location X.

ADDITIONAL INFORMATION

Lined area for additional information.

If more than one screen,  
show location of each on sketch.