

MISSISSIPPI DEPARTMENT OF ENVIRONMENTAL QUALITY

Office of Land and Water Resources

P. O. Box 10631
Jackson, MS 39289-0631

WATER WELL DRILLERS LOG

COUNTY WELL LOCATED Lowndes	
WELL NUMBER 2367	CODED
C 2118	
DATE WELL COMPLETED 12-6-95	

PERMIT NUMBER 0-379
NAME OF DRILLING FIRM Mid-South Drilling
Carrollton, AL 35447

NAME & MAILING ADDRESS OF LANDOWNER O. C. Electric (contractor)			
P. O. Box 581			
Columbus, MS 39703			
WELL LOCATION:	SEC 24SE	TOWNSHIP 17	RANGE 19
		N	E
		S	W
DISTANCE 3	DIRECTION NW	NEAREST TOWN Columbus	
OTHER LANDMARK			
WELL PURPOSE: Home, Irrigation, Municipal, Industrial, Fish Pond, etc. home			

PUMP DATA		
PUMP TYPE (Circle One): Submersible, Turbine, Jet, Flowing Well, Other (Describe) _____		
POWER TYPE (Circle One): Electric, Tractor, Diesel, Gasoline, Butane, Other (Describe) _____ H/P _____		
Pump Capacity (GPM)	No. of Stages	Setting Depth FT.
PUMP TEST		
Well yielded _____ GPM with a drawdown of _____ ft. after _____ hours of pumping		

WELL DATA		
Well Depth 290	Casing Diameter (In.) 4"	Casing Length (Ft.) 112'
Type of Casing PVC	Hole Depth 290'	Depth to Static Water Level 15'
TYPE OF COMPLETION: (Circle One or More): Gravel Packed, Underreamed, Telescoped, Natural Development, Open Hole , Other		
WELL GROUTED TO A DEPTH OF _____ FEET Type Grout (circle one): Cement, Bentonite, or Mix		

LOG DATA	
TYPE OF LOG RUN (Circle One): Electric, Gamma Ray, Density, Sonic, Neutron, Other (Describe) _____	
Name of Organization Running Log RECEIVED	


SCREEN DATA		
Diameter - Inches	Length - Feet	Slot Size - Inches
Screen Type	Depth to Bottom - Feet	

GEOLOGIC DATA (Office Use Only)			
Surface Elev.	Geologic Unit	Unit Thickness	Depth to Top
Subs. SWL	Date Dept. of Environmental Quality	Analysis	Aquifer Test
Driller's Remarks Office of Land & Water Resources			
Top of Lap Pipe or Reduction in Casing FEET IF TELESCOPED OR MORE THAN ONE SCREEN: USE BACK PAGE			

DESCRIPTION OF FORMATIONS ENCOUNTERED	FROM	TO	FORMATIONS (Continued)	
			FROM	TO
sand	000	012	clay w/sand streaks	192 238
clay	012	014	sand	238 243
sand & gravel	040	050	clay	243 274
clay	050	085	sand	274 281
sand	085	100	clay	281 290
clay	100	118		
sand	118	121		
clay	121	135		
sand	135	150		
clay	150	175		
sand	175	192		
IF MORE SPACE IS NEEDED, USE BACK				

If well telescopes please
sketch and show depths.

GROUND LEVEL

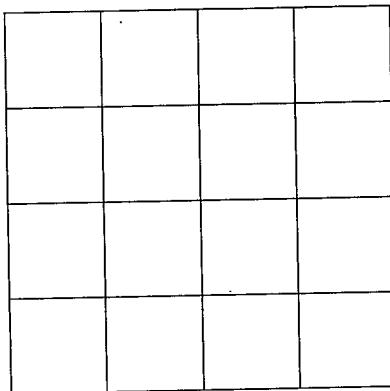

SECTION _____

Please indicate well location X.

ADDITIONAL INFORMATION

If more than one screen,
show location of each on sketch.