

MISSISSIPPI DEPARTMENT OF ENVIRONMENTAL QUALITY

Office of Land and Water Resources

P. O. Box 10631
Jackson, MS 39289-0631
WATER WELL DRILLERS LOG

COUNTY WELL LOCATED <u>Ground</u>	
WELL NUMBER <u>C-2126</u>	CODED
DATE WELL COMPLETED <u>9/12/02</u>	

PERMIT NUMBER
NAME OF DRILLING FIRM <u>Clardy Well</u> <u>Columbus, MS</u>

NAME & MAILING ADDRESS OF LANDOWNER <u>Albert Glenn</u> <u>1522 Spriley Rd.</u> <u>Columbus, MS</u>			
Latitude:			
Longitude:			
WELL LOCATION	SEC	TOWNSHIP	RANGE
	<u>26</u>	<u>T17</u>	<u>N R18</u>
DISTANCE	DIRECTION		NEAREST TOWN
<u>2</u> Miles	<u>N</u>		of <u>Columbus</u>
OTHER LANDMARK			
WELL PURPOSE: Home, Irrigation, Municipal, Industrial, Fish Pond, etc. <u>Irrigation</u>			

WELL DATA		
Well Depth <u>202</u>	Casing Diameter (In.) <u>40</u>	Casing Length (Ft.) <u>109'</u>
Type of Casing <u>PVC</u>	Hole Depth <u>30'</u>	Depth to Static Water Level

TYPE OF COMPLETION: (Circle One or More):			
Gravel Packed,	Underreamed,	<u>Telescoped,</u>	Other
Natural Development,	Open Hole,		
(Describe)			
WELL GROUTED TO A DEPTH OF <u>20</u> FEET			
Type Grout (circle one): Cement, <u>Bentonite</u> , or Mix			

SCREEN DATA		
Diameter - Inches <u>2"</u>	Length - Feet <u>40'</u>	Slot Size - Inches <u>.013</u>
Screen Type <u>PVC</u>	Depth to Bottom - Feet	

PUMP DATA		
PUMP TYPE (Circle One): <u>Submersible</u> Turbine, Jet, Flowing Well, Other (Describe)		
POWER TYPE (Circle One): <u>Electric</u> Tractor, Diesel, Gasoline, Butane, Other (Describe) H/P <u>1/2</u>		
DESCRIPTION OF FORMATIONS ENCOUNTERED	FROM	TO
<u>Red + white clay</u>	<u>0</u>	<u>13</u>
<u>Sand + gravel</u>	<u>13</u>	<u>27</u>
<u>Blue clay</u>	<u>27</u>	<u>70</u>
<u>Rocky sandycl.</u>	<u>70</u>	<u>82</u>
<u>Clay streak</u>	<u>82</u>	<u>95</u>
<u>Clay</u>	<u>95</u>	<u>103</u>
<u>Sandy clay</u>	<u>103</u>	<u>107</u>
<u>Clay</u>	<u>107</u>	<u>110</u>
<u>Sandy rocky cl.</u>	<u>110</u>	<u>119</u>
<u>Clay</u>	<u>119</u>	<u>125</u>
<u>Sandy clay</u>	<u>125</u>	<u>134</u>
<u>Rocky sandy ot.</u>	<u>134</u>	<u>156</u>
<u>Clay</u>	<u>156</u>	<u>173</u>
<u>Rocky sandy ot.</u>	<u>173</u>	<u>199</u>
<u>Clay</u>	<u>199</u>	<u>202</u>
RECEIVED		
OCT 01 2002		
BY: OLWR		
Top of Lap Pipe or Reduction in Casing		
FEET	IF TELESCOPED OR MORE THAN ONE SCREEN: USE BACK PAGE	


I certify that the well was drilled, constructed and completed in accordance with all applicable Requirements of the Mississippi Department of Environmental Quality and/or the Mississippi Department of Health regulations and state laws.

Don Chubb 0-496
Signature of Licensed Driller and License No.

9/28/02
Date

Additional Information Required On Back

If well telescopes please sketch and show depths.

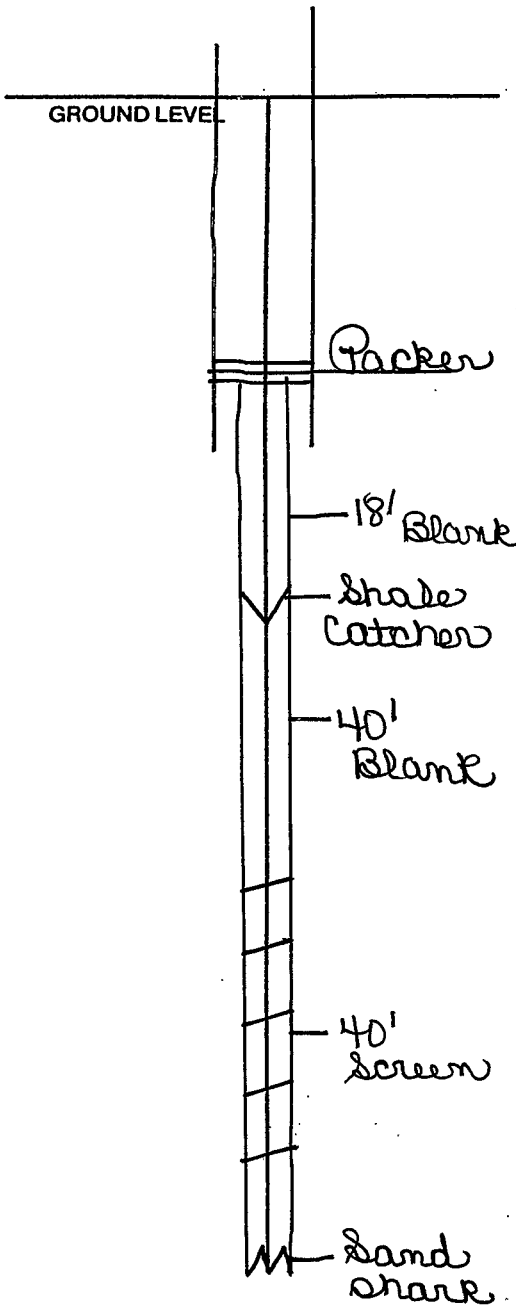

If more than one screen, show location of each on sketch.

SECTION _____

Please indicate well location X.

Pump Capacity (GPM)	No. of Stages	Setting Depth
30	15	80 FT.

PUMP TEST

Well yielded _____ GPM with a drawdown of _____ ft. after _____ hours of pumping

LOG DATA

TYPE OF LOG RUN (Circle One): No Log Run, Electric, Gamma Ray, Density, Sonic, Neutron, Other (Describe) _____

Name of Organization Running Log _____

GEOLOGIC DATA (Office Use Only)

Surface Elev.	Geologic Unit	Unit Thickness	Depth to Top
Subs. SWL	Date	Analysis	Aquifer Test

Driller's Remarks

Rough hand packer