

D

10-28-61

WATER WELL DRILLERS LOG

Date: Oct 28, 1961, Driller: W.B. Clardy County (Lauderdale)

9311 13234

(Name)

(1) Owner of Land: Burgess
 (Name)
Rt 2 - Hwy 50
 (Address)
 (2) Location: 1/4, 1/4, Sec. 36 T2 R17W
8 miles NE of Colo.
 (distance) (direction) (Nearest Town)
 (3) Topography: Level
 (Hilly) (Flat) (Level)
 (4) Purpose of Well: Domestic
 (Domestic Irrigation, Municipal, Industrial, Other)


Description & Color of Materials Sand, Clay, Red Clay, Shell, etc.	Thick- ness Feet	Depth Feet
Gravel	16'	33'
Blue Clay	33'	115'
Sand	115'	117'
Blue Clay	117'	160'
Sand	160'	165'
Clay	165'	200'
Sand	200'	208'
Clay	208'	212'
Sand	212'	220'

Information upon completion of well:

(1) Diameter 4 inches.
 (2) Total Depth 225 feet.
 (3) Water Level 90 feet below top of ground.
 (4) Cased to 81, Size 4"
 (5) Screen: Size _____, Length _____
 (6) Were any formations sealed against pollution?
 _____ yes, _____ no.

If YES depth of formation _____
 Why _____

Drillers Remarks: _____

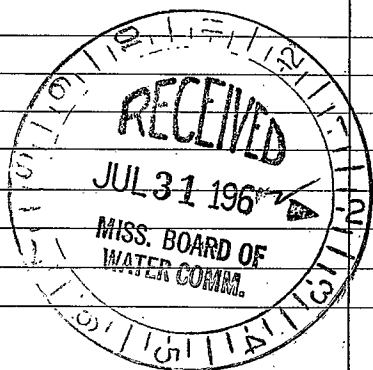

(Use Back Side)

Well No.

