


If well telescopes please sketch and show depths.

GROUND LEVEL

28'
4" METAL
CASING

98'
Rock

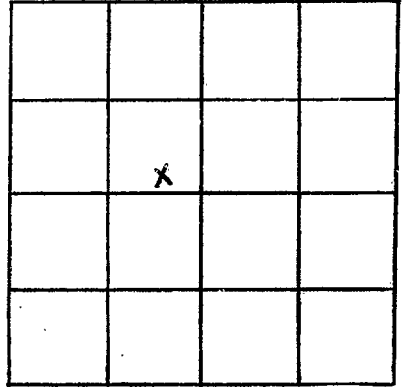

SECTION 31

Please indicate well location X.

ADDITIONAL INFORMATION

If more than one screen,
show locations of each on sketch.