

LOWNDES
D 21
6-10-71

MISSISSIPPI
 BOARD OF WATER COMMISSIONERS
 416 North State Street
 Jackson, Mississippi 39201

CODED

WATER WELL DRILLERS LOG

6/10 1971 Allsup Drilling Co. LOWNDES
 date well completed firm name county well located

LANDOWNER:
John Sneed
Columbus, Miss
 (mailing address)

| description of formations encountered | from | to |
|---------------------------------------|------------|------------|
| <u>SANDY CLAY</u> | <u>0</u> | <u>2</u> |
| <u>GRAVEL ROCK</u> | <u>2</u> | <u>100</u> |
| <u>SAND</u> | <u>100</u> | <u>178</u> |

WELL LOCATION:
 sec 31 T 17 S R 17 E WEST
2 1/2 miles NE of Columbus
 (distance) (direction) (nearest town)

WELL PURPOSE:
 (home, irrigation, municipal, industrial)

- WELL COMPLETION DATA:
- (1) diameter (inches) 4"
 - (2) total depth (feet) 178
 - (3) static water level (feet) 5' below top of ground.
 - (4) casing METAL 27'
 (material) (depth)
4"
 (size) if telescope see back.
 - (5) screen NONE
 (length) (depth to top)
 (size) (material)
 - (6) pump _____
 (HP) (yield gpm)
ELECTRIC
 (type power)
 - (7) electric log No
 (yes or no)

 (organization running log)
 - (8) how well bottom plugged _____


CODED

JUL 7 1971

DRILLERS REMARKS:


MISS. BD. OF
 WATER COMM.

If well telescopes please sketch and show depths.

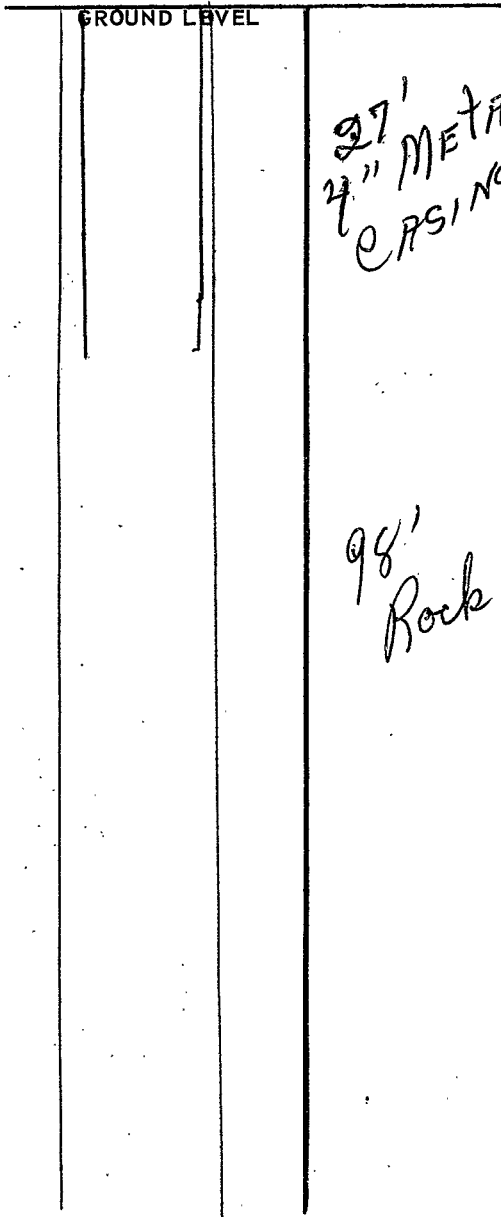

27'
4" METAL
CASING

98'
Rock

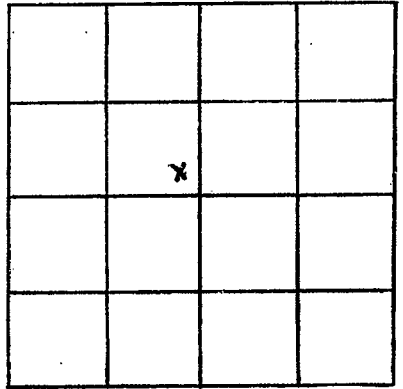

SECTION 31

Please indicate well location X.

ADDITIONAL INFORMATION

If more than one screen,
show locations of each on sketch.