

CODED

MISSISSIPPI
BOARD OF WATER COMMISSIONERS
416 North State Street
Jackson, Mississippi 39201

LOWNDES
D22
10-4-69

WATER WELL DRILLERS LOG

10-4-69 19 Columbus Well Drilling & Digging Lowndes
date well completed firm name county well located

LANDOWNER: Leslie Perkins
Caledonia, Miss.
(mailing address)
WELL LOCATION:
sec. 22 T. 6 N R. 17 E
3 miles S of Caledonia
(distance) (direction) (nearest town)

description of formations encountered	from	to
Top soil & clay	0	10
Sand and gravel	10	25
Soft blue clay	25	30
Fine sand	30	40
White, red, brown, green & rusty formation	40	90
Blue clay	90	120
Streaks of sand & clay	120	145
Sand	145	150
Clay	150	160
Sand	160	165
Clay	165	205
Sand	205	220

WELL PURPOSE: Home
(home, irrigation, municipal, industrial)


WELL COMPLETION DATA:
(1) diameter (inches) 4"
(2) total depth (feet) 220 feet
(3) static water level (feet) _____ below above top of ground.
(4) casing 97 1/2 ft. (steel)
(material) (depth)
(size) if telescope see back.
(5) screen _____
(length) (depth to top)
(size) (material)
(6) pump 1/2 600
(HP) (yield gpm)
220
(type power)
(7) electric log _____
(yes or no)
(organization running log)
(8) how well bottom plugged open

DRILLERS REMARKS:

DEC - 1 1969
REG. MISS. BD. OF
WATER COMMISSIONERS

If well telescopes please sketch and show depths.

GROUND LEVEL

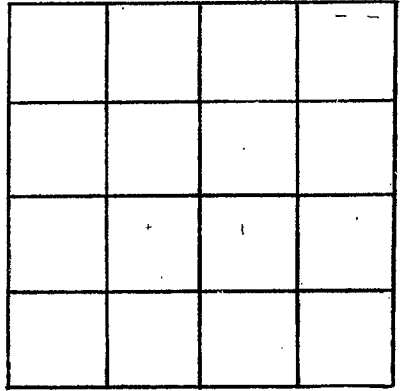

SECTION _____

Please indicate well location X.

ADDITIONAL INFORMATION

If more than one screen, show locations of each on sketch.