

CODED

CODED

CODED

Lowndes  
D27  
1-69

MISSISSIPPI  
BOARD OF WATER COMMISSIONERS  
416 North State Street  
Jackson, Mississippi 39201

WATER WELL DRILLERS LOG

Year: 1969  
Date well completed: Part same as store  
Firm name: Star Rt. 3566914  
Take: 1st gravel Rd Left  
County well located: ON LEFT at house with Beck's house

LANDOWNER: Jude Gilmer

description of formations encountered

Star Rt. 3566914  
Caledonia Miss.  
(mailing address)

description of formations encountered	from	to
Top soil	0	10
Sand & gravel	10	40
blue Clay	40	60
fine sand & soft clay	60	70
blue Clay	70	75
fine sand	75	77
blue Clay	77	85
fine sand & soft clay	85	100
blue Clay	100	120
blue Clay	120	140
stricks of sand & clay	140	150
blue Clay	150	160
sand	160	168

WELL LOCATION: 17  
32 sec T. 19 N R. 13 E  
3 miles NE of Colo.  
(distance) (direction) (nearest town)

WELL PURPOSE: home  
(home, irrigation, municipal, industrial)

WELL COMPLETION DATA:

- (1) diameter (inches) 4"
- (2) total depth (feet) 168
- (3) static water level (feet) 1' below top of ground.
- (4) casing Steel 46' (material) (depth)
- (5) screen (length) (depth to top)
- (6) pump (HP) (yield gpm)
- (7) electric log (yes or no)
- (8) how well bottom plugged

CODED


DRILLERS REMARKS:

MAR 11 1969

MISS. Bd. of WATER

If well telescopes please sketch and show depths.

GROUND LEVEL

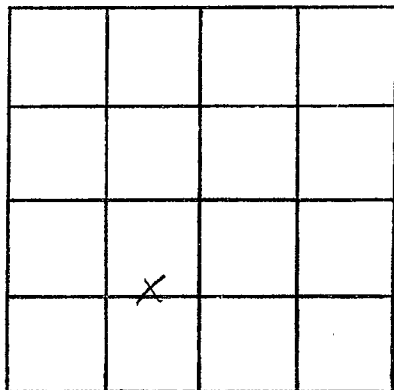

SECTION 132

Please indicate well location X.

ADDITIONAL INFORMATION

If more than one screen, show locations of each on sketch.