

LOWNDES
D 31
9-22-73

MISSISSIPPI
 BOARD OF WATER COMMISSIONERS
 416 North State Street
 Jackson, Mississippi 39201

OCT 19 1973
 CODED

WATER WELL DRILLERS LOG

MISS. BD. OF
 WATER COMMISSIONERS
 LOWNDES

Sept 22 1973 date well completed
 C. A. R. D. V. Well + Pump firm name
 LOWNDES county well located

LANDOWNER: Floyd Taylor
 Wolf Rd.
 Caledonia, Miss
 (mailing address)

WELL LOCATION:
 sec. 6 T. 17 R. 17
 12 miles N of Col
 (distance) (direction) (nearest town)

WELL PURPOSE: home
 (home, irrigation, municipal, industrial)

WELL COMPLETION DATA:

- (1) diameter (inches) 4
- (2) total depth (feet) 155
- (3) static water level (feet) 16 below top of ground.
- (4) casing 4" steel, 62' (material) (depth)
- if telescope see back. (size)
- (5) screen 0 (length) (depth to top)
- (size) (material)
- (6) pump (HP) (yield gpm)
- (type power)
- (7) electric log (yes or no)
- (organization running log)
- (8) how well bottom plugged


description of formations encountered	from	to
clay gravel	0	15
sand	15	20
sand + gravel	20	35
sandy blue clay	35	40
fine sand + clay	40	57
blue clay	57	75
streaks of sand + clay	75	90
brown clay	90	95
grey clay	95	100
blue clay	100	125
sand	125	155

CODED

DRILLERS REMARKS: Owner installed pump

If well telescopes please sketch and show depths.

GROUND LEVEL

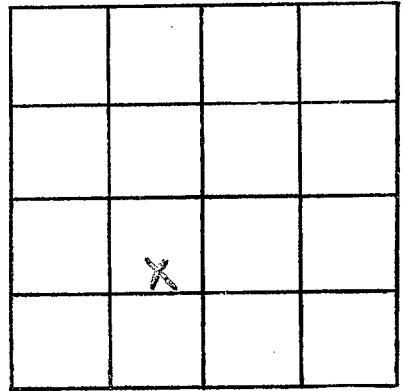

SECTION 6

Please indicate well location X.

ADDITIONAL INFORMATION

If more than one screen,
show locations of each on sketch.