

MISSISSIPPI DEPARTMENT OF NATURAL RESOURCES

Bureau of Land and Water Resources

Southport Mall

P.O. Box 10631

Jackson, Mississippi 39209

CODED

WATER WELL DRILLERS LOG

Lowndes
D34
5-13-81

Griner Drilling Service, Inc.

Lowndes

5-13-81
date well completed

Griner Drilling Service, Inc.
firm name

Lowndes
county well located

LANDOWNER:
Patrick Petroleum
205 Highland Village
Jackson, Ms 39219
(mailing address)

description of formations encountered	from	to
<u>sand + gravel</u>	<u>0</u>	<u>42</u>
<u>clay</u>	<u>42</u>	<u>210</u>
<u>clay + sand</u>	<u>210</u>	<u>294</u>
<u>sand</u>	<u>294</u>	<u>336</u>
<u>clay</u>	<u>336</u>	<u>420</u>

WELL LOCATION: 2063' S + 525' W
No. 34 sec. 17 T. 17 N. R. 12 E. of
E.C. Davis Columbia
34 miles (distance) (direction) (nearest town)

WELL PURPOSE: oil field supply
(home, irrigation, municipal, industrial)

WELL COMPLETION DATA:

(1) diameter (inches) 3"

(2) total depth (feet) 420'

(3) static water level (feet) 50' below top of ground.

(4) casing steel, 336'
(material) (depth)

3"
(size) if telescope see back.

(5) screen 42', 294'
(length) (depth to top)

3", perforated
(size) (material)

(6) pump -, 80
(HP) (yield gpm)

AC
(type power)

(7) electric log -
(yes or no)

(organization running log)

CODED

(8) how well bottom plugged orange
peel

DRILLERS REMARKS:


DEPT. OF NATURAL RESOURCES
BUREAU OF LAND & WATER RESOURCES

MAY 28 1981

RECEIVED

If well telescopes please
sketch and show depths.

GROUND LEVEL

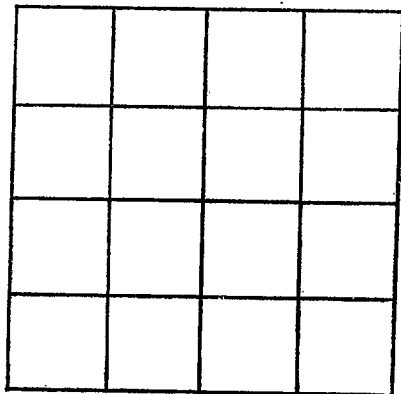

SECTION _____

Please indicate well location X.

ADDITIONAL INFORMATION

If more than one screen,
show locations of each on sketch.