
State Well Report For Office Use Only: County: LOW Part 1 – Driller's Log Mississippi Department of Environmental Quality Aquifer: Office of Land and Water Resources Permit #: Well #: P.O. Box 10631 Driller: Jackson, MS 39289-0631 L. S. Elevation (601)961-5210 Date drilling completed: (601)354-6938 (fax) E-log #: State Law requires that this report be prepared by the license holder responsible for the work and filed with the Department at the above address within 30 days of completion of drilling of the well or borehole. Well or Borehole Location Information on Well Owner (Landowner if borehole is not for a water well) 3.6020 AMES TAYLOR 33-34 **71** 88-19 Method of Lat/Long (circle one): Conventional Survey, Owner Namer ALOCK RD Mailing Address: USGS quad, Hand-held GPS, Survey-grade GPS ENS MS 39766 S Rng 39766 Direction Nearest Town Zip Code Distance 7 Miles Telephone No. (662 321 - 7386 SIFE Well / Borehole Data 5 nelths Date drilling started: 7-7-07 Date drilling completed: 7-1-07 Hole depth: 26 Hole diameter: 2 Location of the source of any surface water used for drilling: LowNDFE COUNTY Method of dosing and volume of Chlorine used in drilling and development: Logs run (circle all applicable): (No log run) Electric Gamma Ray Density Sonic Neutron Other: Name of organization running log(\$). Purpose of borehole (check one): Water Well Cectechnical/Geological Investigation Ground Source Heat Pump Seismic Survey___ Other (describe) If drilling is not related to water well construction, skip the remainder of this block Other: CowRE Fish Culture Irrigation Industrial Public Supply Purpose of Well (check one): Home Other (describe) If a flowing well, method of flow regulation: Valve Static Water Level: 12 FT, Date measured feet above or below (circle one) land surface electric tape air line other: (steel tape) Method of Measurement (circle one) Type of grout (circle one): Neat Cement Bentonite _ Well grouted to a depth of feet Well depth: _ Type of casing: GAV. PIPE, inches Casing diameter: 1/4 fæt Casing length: Type of screen: ME7 Screen diameter: 1/4 inches fœt Screen length: Screen slot size: 060 GRIT ኋ4 Setting depth: From _ feet feet to Open hole Natural Development Underreamed Telescoped Gravel packed Type of completion (circle all applicable): CLOSE ON OWN WI IOLE Other (describe): 11 feet. If telescoped or more than one screen, describe on next page Top of lap pipe or reduction in casing: _ Form: OLWR-SWR-1A

The sketch below only required for water wells

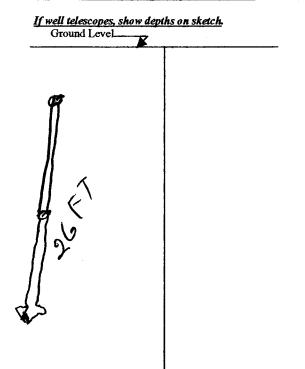

Description of formations encountered must be provided for all wells and boreholes, unless specifically exempted by regulations

Description of Formations Encountered From (depth) To (depth)

Description of Formations Encountered		It (ucpu)
·	Ground Level	
DIRI	0	12FT
DIRT CLIFY SAND& CRAVEL	12FT	12 F1 14 F1 26 F1
SAND & OKALIEL	14	2LF1
		F
		+
		++
	+	+
		+
·····	·	
		1
	· • · · · · · · · · · · · · · · · · · ·	+
		11
	+	+
		+
		

If more than one screen, show location of each on sketch

Sketch the property layout and include the following: 1) the well location; 2) any permanent structures on the property that may aid in locating the well; 3) any roads, power lines, or other items that may aid in locating the property and the well; 4) a north arrow. NOTE: TITIS WELL WAS PUT DOWN FOR COWS WATER HOLE WEGT DRY ON SMALL FARM OFF BLACKIOCK RA STEENS, MS. 39766 OCT 0 3 2007 BY: OLWR Landowner Name: JAMES TAYLOR Form: OLWR-SWR-1A

I certify that the well/borehole was drilled, constructed, and completed in accordance with all applicable requirements of the Mississippi Department of Environmental Quality and the Mississippi Department of Health regulations, if applicable, and state

Date

laws. JOE JOHNSON 07191 1007.07

Thate

Print Name of Responsible Licensee and License No.

Signature of Licensee

STATE WELL REPORT		
County: LOWNDES	Part 2 For Office Use Only:	
	er's Completion Report ment of Environmental Quality Aquifer:	
Office of Lan	id and Water Resources	
	D. Box 10631 D. MS 39289-0631 Well #:	
(-	01)961-5210 354-6938 (fax) Elevation:	
This part of the report must be completed by a licensed water well contractor or a licensed pump installer. A copy of Part 1 of the		
report must be attached and both parts filed with the Department at the above address within 30 days of well completion.		
Well Owner Information	$\begin{array}{c c} & \text{Well Location} \\ \hline & & \\ \hline \\ \hline$	
Owner Name: JAMES TAYLOR		
Method of Lab Long (check one): Conventional Survey		
STEENS MS 39766	USGS quad, Hand-held GPSX, Survey-grade GPS	
STETENS MS 39166	75 39166 SE% NIV % Sec 33 T_175 R_17W	
City State Zip Code	Code Distance Direction Nearest Town	
elephone No. (662 321-7386] Miles IN of STELENS MS		
Ритр Туре	Power Type	
Circle one	Circle one	
Air Lift Jet Submersible	Diesel Engine Gasoline Engine Natural Gas	
Bucket Piston Turbine	Electric Motor Hand Tractor PTO	
Centrifugal Rotary Flowing Well	Electric Motor Hand Tractor PTO Windmill Other (specify): $\frac{RECEIVEL}{1fP}$, $\frac{RECEIVEL}{032007}$ Setting Depth: $\frac{12}{F1}$ forth	
Other (specify): <u>Y3 HP Gould</u> Horse Power Rating of Motor: <u>Y2 If P</u> , <u>CCEIVE</u>		
Date Pump Installed: <u>7.1)-07</u> Setting Depth: <u>12, F7</u> feet		
Rated Pump Capacity: 4 Gallons Per Minute	Setting Depth: 12 FT feed y 01 3 2007 Number of Stages: 1STAGE BY 01 WR	
Pump Test Data	Method of Measuring Water Level Circle one	
Date Well Tested:		
Static Water Level (A): Feet Below Land Surface Air Line Electric Measuring Line Steel Tape		
Pumping Water Level (B): / Feet Below Land Surface Other (specify):		
Drawdown [(B) - (A)]:Feet Below Land Surface For flowing well, measured shut in head:feet		
Test Pumping Rate:Gallons Per Minute Well yieldedGPM with a drawdown of		
Duration of Pump Test (minimum 4 hours): 6 hours feet after 6 hours of pumping		
I HEREBY CERTIFY that the above statements are true to the best of my knowledge.		
JUE JOINTAL UNE above statements are une best of my phowiedge through		
Print Name of Pump Installer and License No. (if applicable) Signature of Pump Installer		

* .

Form: OLWR-SWR-1B