

WATER WELL DRILLERS LOG

Date: Jan. 4, 1963, Driller: W. B. Clardy County Lumbert

(1) Owner of Land: Church of Christ (Name) Steens, Miss. (Address)

(2) Location: NW 1/4, NW 1/4, Sec. 27 T17R17W miles of (distance) (direction) (Nearest Town)

(3) Topography: Flat (Hilly) (Flat) (Level)

(4) Purpose of Well: (Domestic Irrigation) (Municipal, Industrial, Other)

Description & Color of Materials Sand, Clay, Red Clay, Shell, etc. Thickness Feet Depth Feet


Gravel 5' to 25' Blue clay 25' to 60' Sand from 60' to 62' Blue clay 62' to 85' Sand from 85' to 105'

Information upon completion of well:

- (1) Diameter 4" inches. (2) Total Depth 105' feet. (3) Water Level 4' feet below top of ground. (4) Cased to 42', Size 4" (5) Screen: Size, Length (6) Were any formations sealed against pollution? yes, no.

If YES depth of formation Why

Drillers Remarks:

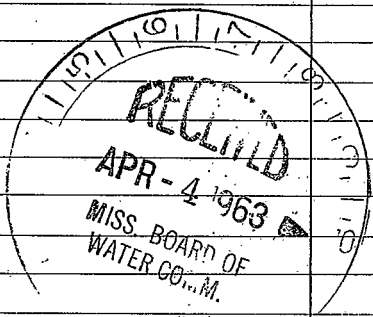

(Use Back Side)

Well No.

Handwritten text at the top of the page, possibly a header or title.

Handwritten text in the upper left quadrant, appearing as a list or series of notes.

Handwritten text in the upper right quadrant, possibly a date or reference.

Handwritten text in the middle right area.

Handwritten text in the lower right quadrant, possibly a signature or date.