

Lowndes
 D 2001
 12-15-75

MISSISSIPPI
 BOARD OF WATER COMMISSIONERS
 416 North State Street
 Jackson, Mississippi 39201

WATER WELL DRILLERS LOG

12/15 date well completed 1975 Norman P. Chab firm name Lowndes county well located

LANDOWNER:
 Leon Morgan
 Columbus, Miss
 (mailing address)

description of formations encountered	depth	
	from	to
top soil	0	10
Sand & Gravel	10	40

WELL LOCATION:
 sec. 30 T. 17 N R. 19 E
 3 miles North E of Columbus
 (distance) (direction) (nearest town)

WELL PURPOSE: None
 (home, irrigation, municipal, industrial)

- WELL COMPLETION DATA:
- (1) diameter (inches) 4"
 - (2) total depth (feet) 40'
 - (3) static water level (feet) 12' below top of ground.
 - (4) casing 42' 21' slotted
 (material) (depth)
 _____ if telescope see back.
 (size)
 - (5) screen _____
 (length) (depth to top)

 (size) (material)
 - (6) pump 1 (HP) 4 (yield gpm)
 1/2 (type power)
 - (7) electric log _____
 (yes or no)

 (organization running log)
 - (8) how well bottom plugged _____


DRILLERS REMARKS:

RECEIVED
 FEB 5 1976

MISS. BD. OF WATER COMMISSIONERS

If well telescopes please sketch and show depths.

GROUND LEVEL

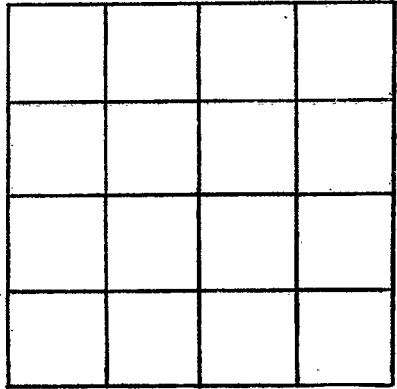

SECTION _____

Please indicate well location X.

ADDITIONAL INFORMATION

If more than one screen,
show locations of each on sketch.